

CORRECTED COPY
CARD MUST BE TYPED

State of Kansas
NOTICE OF INTENTION TO DRILL
(see rules on reverse side)

CORRECTED COPY
CORRECTION
CARD MUST BE SIGNED
3-13-85

Starting Date: March 12, 1985
month day year

OPERATOR: License # 5068
Name Thomas E. Black
Address 527 Union Center Bldg.
City/State/Zip Wichita, Kansas 67202
Contact Person Thomas E. Black
Phone 264-9342

CONTRACTOR: License # 5110
Name B & B Drilling, inc.
City/State Wichita, Kansas

Well Drilled For:	Well Class:	Type Equipment:
<input checked="" type="checkbox"/> Oil <input type="checkbox"/> Swd <input checked="" type="checkbox"/> Infield		<input checked="" type="checkbox"/> Mud-Rotary
<input type="checkbox"/> Gas <input type="checkbox"/> Inj <input type="checkbox"/> Pool Ext.		<input type="checkbox"/> Air Rotary
<input type="checkbox"/> OWWO <input type="checkbox"/> Expl <input type="checkbox"/> Wildcat		<input type="checkbox"/> Cable

If OWWO: old well info as follows:

Operator
Well Name
Comp Date Old Total Depth
Projected Total Depth 3800 feet
Projected Formation at TD B/KC
Expected Producing Formations L/KC

I certify that we will comply with K.S.A. 55-101, et seq., plus eventually plugging hole to K.C.C. specifications.

Date 2-28-85 Signature of Operator or Agent

Thomas E. Black

Title Owner

API Number 15- 065-22,152 - 0000

~~Approx. C NW SW~~ ^{NW SE}
(location) Sec 35 Twp 10 S, Rge 23 East West

1980 Ft North from Southeast Corner of Section

1980 Ft West from Southeast Corner of Section

(Note: Locate well on Section Plat on reverse side) -

Nearest lease or unit boundary line 660 feet.

County Graham

Lease Name Schaben Well# 2

Domestic well within 330 feet: yes no

Municipal well within one mile: yes no

Depth to Bottom of fresh water .. 160 feet

Lowest usable water formation Dakota

Depth to Bottom of usable water 950 feet

Surface pipe by Alternate: 1 2

Surface pipe to be set 250 feet

Conductor pipe if any required feet

Ground surface elevation not available feet MSL

This Authorization Expires 9-1-85


Approved By 3-1-85

Thomas E. Black ^{was C NW SW} 4620 FEL

Must be filed with the K.C.C. five (5) days prior to commencing well
This card void if drilling not started within six (6) months of date received by K.C.C.

Important procedures to follow:

**A Regular Section of Land
1 Mile = 5,280 Ft.**

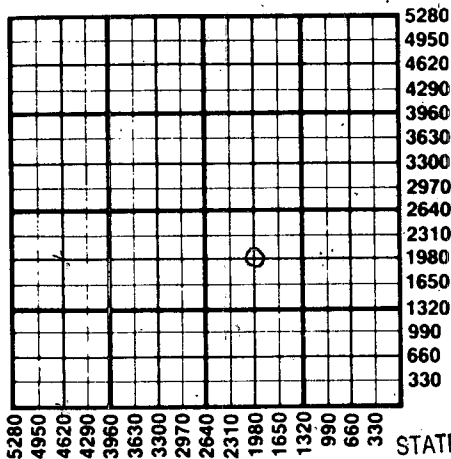

1. Notify District office before setting surface casing.
2. Set surface casing by circulating cement to the top.
3. File completion forms ACO-1 with K.C.C. within 90 days of well completion, following instructions on ACO-1, side 1, and including copies of wireline logs.
4. Notify District office 48 hours prior to old well workover or re-entry.
5. Prior to plugging, prepare a plugging plan, then obtain agreement from the appropriate district office for an approved plugging plan.
6. Submit plugging report (CP-4) to K.C.C. after plugging is completed.
7. Obtain an approved injection docket number before disposing of salt water.
8. Notify K.C.C. within 10 days when injection commences or terminates.
9. If an alternate 2 completion, cement in the production pipe from below any usable water to surface within 120 days of spud date.

RECEIVED

STATE CORPORATION COMMISSION

State Corporation Commission of Kansas

Conservation Division

200 Colorado Derby Building

Wichita, Kansas 67202

(316) 263-3238

MAR 13 1985

CONSERVATION DIVISION

Wichita, Kansas