


STATE OF KANSAS
STATE CORPORATION COMMISSION

WELL PLUGGING RECORD

Give All Information Completely
Make Required Affidavit
Mail or Deliver Report to:
Conservation Division
State Corporation Commission
211 No. Broadway
Wichita, Kansas

NORTH

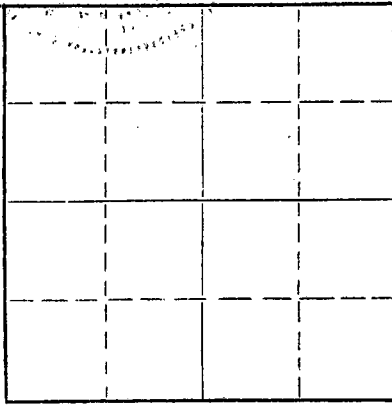

Locate well correctly on above
Section Plat

GRAHAM County, Sec. 5 Twp. 10S Rge. 24 (W)

Location as "NE/CNW/SW" or footage from lines. NE SW NE

Lease Owner LIBERTY ENTERPRISES INC.

Lease Name GANO Well No. 3

Office Address 305 W MILL, PLAINVILLE, KS 67663

Character of Well (completed as Oil, Gas or Dry Hole) DRY HOLE

Date well completed 2/3/77 19.

Application for plugging filed 2/3/77 19.

Application for plugging approved 2/3/77 19.

Plugging commenced 2/3/77 19.

Plugging completed 2/3/77 19.

Reason for abandonment of well or producing formation TOO LOW STRUCTURALLY

If a producing well is abandoned, date of last production 19.

Was permission obtained from the Conservation Division or its agents before plugging was commenced? YES

Name of Conservation Agent who supervised plugging of this well GILBERT BALTHAZOR, PALCO, KS

Producing formation Depth to top Bottom Total Depth of Well 4005' Feet

Show depth and thickness of all water, oil and gas formations.

OIL, GAS OR WATER RECORDS

CASING RECORD

FORMATION	CONTENT	FROM	TO	SIZE	PUT IN	PULLED OUT
				8 5/8"	194.84'	NONE

Describe in detail the manner in which the well was plugged, indicating where the mud fluid was placed and the method or methods used in introducing it into the hole. If cement or other plugs were used, state the character of same and depth placed, from feet to feet for each plug set.

FILLED WITH HEAVY MUD TO 1000'. SET
PLUG. PUT IN 70 SACKS CEMENT. FILLED
WITH HEAVY MUD TO 185'. SET PLUG. PUT
IN 20 SACKS CEMENT. FILLED WITH HEAVY
TO 40'. SET PLUG. FILLED TO TOP WITH
10 SACKS 50-50 POZ.

RECEIVED
STATE CORPORATION COMMISSION
2-11-1977
FEB 11 1977
CONSERVATION DIVISION
Wichita, Kansas

(If additional description is necessary, use BACK of this sheet)

Name of Plugging Contractor C-G DRILLING CO.

Address 1107 DOUGLAS BLDG, 104 SOUTH BROADWAY, WICHITA, KS 67202


STATE OF KANSAS, COUNTY OF SEDGWICK, ss.
JAY H GALLOWAY (employee of owner) or (owner or operator) of the above-described

well, being first duly sworn on oath, says: That I have knowledge of the facts, statements, and matters herein contained and the log of the above-described well as filed and that the same are true and correct. So help me God.

(Signature) JAY H GALLOWAY 1107 DOUGLAS BLDG, 104 S BROADWAY, WICHITA, KS

SUBSCRIBED AND SWORN to before me this 8TH day of FEBRUARY, 19 77

DEBRA L HEERSCHKE Notary Public.

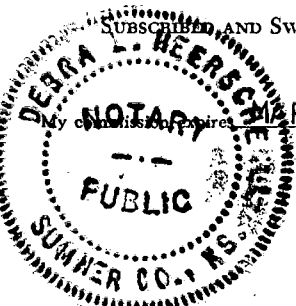

MARCH 3, 1980

W E L L L O G

OPERATOR: LIBERTY ENTERPRISES, INC.
 WELL NAME: GANO #3 LOCATION: NE SW NE
 COUNTY: GRAHAM STATE: KANSAS
 WELL COMMENCED: 1/26/77 WELL COMPLETED: 2/3/77
 ELEVATION: 2493' KB TOTAL DEPTH: 4005'
 PRODUCTION: D & A RIG NO: 1
 CASING - 8-5/8": 5 JTS - 194.85' WITH 140 SX CEMENT +2% GEL +3% CC.
 5-1/2": _____

ALL MEASUREMENTS TAKEN FROM THE TOP OF ROTARY BUSHING:

FROM	TO	FORMATION	DEVIATION FROM VERTICAL	REMARKS:
0	1685	SHALE		
1685	1890	SAND		
1890	2130	RED BEDS & SAND		
2130	2167	ANHYDRITE		
2167	2220	RED BED		
2220	2630	SHALE & SHELLS		
2630	3870	LIME & SHALE		
3870	4005	LIME & RTD		

RECEIVED
 STATE CORPORATION COMMISSION
 2-11-1977
 FEB 11 1977
 CONSERVATION DIVISION
 Wichita, Kansas

DST #1: 3846-3870 OP 30 SI 30 OP 60
 SI 60. WEAK BLOW. REC 150' O&GCM,
 ICHP 1148#, FBHP 1164#, IFP 55#,
 FFP 113#.

DST #2: 3946-4005' OP 60 SI 30 OP 30
 SI 30. WEAK BLOW. REC 90' VSOCM, IBHP
 178#, FBHP 178#, IFP 63#, FFP 103#.

STATE OF KANSAS)
 COUNTY OF SEDGWICK) SS:

The undersigned hereby certifies that to the best of his knowledge and belief, the above facts are true and correct.

C-G DRILLING CO.

By Jay H Galloway
 JAY H GALLOWAY

SUBSCRIBED AND SWORN TO, BEFORE ME, This 10th day of FEBRUARY, 1977.

MY COMM. EXP. DEC. 8, 1979

Phyllis Buchanan
 PHYLLIS BUCHANAN - NOTARY PUBLIC

