


WELL PLUGGING RECORD

Give All Information Completely
Make Required Affidavit
Mail or Deliver Report to:
Conservation Division
State Corporation Commission
800 Bittling Building
Wichita, Kansas

Graham County, Sec. 30 Twp. 10S Rge. 24 (E) W (W)
NE NE NE

Location as "NE/CNW $\frac{1}{4}$ SW $\frac{1}{4}$ " or footage from lines
Lease Owner **Peel-Hardman Oil Producers**
Lease Name **Hanna** Well No. **1**
Office Address **P. O. Box 359, Hoisington, Kansas**
Character of Well (completed as Oil, Gas or Dry Hole) **Dry Hole**
Date well completed **Nov. 17** 19 **51**
Application for plugging filed **Nov. 17** 19 **51**
Application for plugging approved **Nov. 17** 19 **51**
Plugging commenced **Nov. 17** 19 **51**
Plugging completed **Nov. 17** 19 **51**
Reason for abandonment of well or producing formation **Dry Hole**

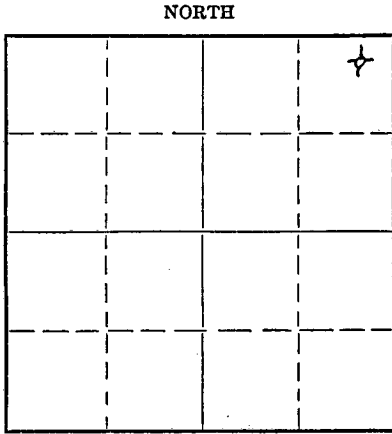

Locate well correctly on above Section Plat

If a producing well is abandoned, date of last production 19
Was permission obtained from the Conservation Division or its agents before plugging was commenced? **Yes**

Name of Conservation Agent who supervised plugging of this well **Eldon Petty**
Producing formation Depth to top Bottom Total Depth of Well **4550** Feet
Show depth and thickness of all water, oil and gas formations.

OIL, GAS OR WATER RECORDS

CASING RECORD

Formation	Content	From	To	Size	Put In	Pulled Out
		0	178'	8 5/8"	178'	None

Describe in detail the manner in which the well was plugged, indicating where the mud fluid was placed and the method or methods used in introducing it into the hole. If cement or other plugs were used, state the character of same and depth placed, from feet to feet for each plug set.

4550' - 226 $\frac{1}{2}$ ' - Heavy Rotary Mud
226 $\frac{1}{2}$ ' - 225' - Wooden Plug
225' - 179' - 15 sacks cement
179' - 41 $\frac{1}{2}$ ' - Heavy Rotary Mud
41 $\frac{1}{2}$ ' - 40' - Wooden Plug
40' - 6' - 10 sacks cement
6' - Surface - Cellar

STATE OF KANSAS
NOV 21 1951
CONSERVATION DIV.
WICHITA, KAN.

(If additional description is necessary, use BACK of this sheet)

Name of Plugging Contractor **Glenn W. Peel**
Address **P. O. Box 359
Hoisington, Kansas**

STATE OF Kansas, COUNTY OF Barton, ss.
Glenn W. Peel (employee of owner) or (~~owner~~) of the above-described well,

being first duly sworn on oath, says: That I have knowledge of the facts, statements, and matters herein contained and the log of the above-described well as filed and that the same are true and correct. So help me God. **GLENN W. PEEL**

(Signature) BY: *Glenn W. Peel*
P. O. Box 359
Hoisington, Kansas (Address)

SUBSCRIBED AND SWORN to before me this 19th day of November, 1951

Marian M. Herbst
Notary Public.

My commission expires June 4, 1955

FILE SEC 30 T 10 R 24 W
BOOK PAGE 178 LINE 25

DRILLER'S LOG

Company: Peel-Hardman Oil Producers

NE NE NE
Sec. 30 Tpw. 10S, Rge. 24W,

Farm: Hanna Well No. 1
Total Depth: 4550'

County: Graham,
Kansas

Comm: 11-3-51 Comp: 11-17-51

Elevation:

Contractor: Glenn W. Peel

Production: Dry

Casing: 8 5/8" 178' cem.

Figures below indicate bottom of formations

Surface Sand	0 -	40
Sand & Clay		150
Shale		1320
Shale & Sand		1820
Shale & Shells		2500
Lime		2960
Lime & Shale		3155
Lime		4060
Shale & Lime		4255
Chert & Lime		4380
Lime		4500
Lime & Chert		4550
Total Depth		4550

This is to certify that the above information is, to the best of our knowledge true and correct.

GLENN W. PEEL

BY: Glenn W. Peel

SUBSCRIBED AND SWORN to before me this 19th day of November, 1951.

My commission expires June 4, 1955 Marion M. Herbert
Notary Public



RECEIVED
STATE CORPORATION COMMISSION
NOV 21 1951
CONSERVATION DIVISION
Wichita, Kansas

FILED
FILE SEC. 30 T. 10 R. 24 W.
BOOK PAGE 120 LINE 26