


WELL PLUGGING RECORD

Give All Information Completely
Make Required Affidavit
Mail or Deliver Report to:
Conservation Division
State Corporation Commission
800 Biting Building
Wichita, Kansas

NORTH

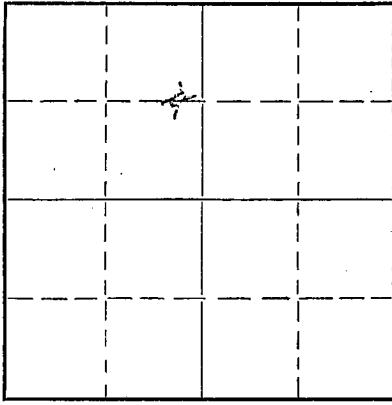

Locate well correctly on above Section Plat

30 PRKCC
Graham County. Sec. 32 Twp. 10. Rge. 24 (E) (W)
Location as "NE/CNW $\frac{1}{4}$ SW $\frac{1}{4}$ " or footage from lines 1320' N.I. 330' E. Line
Lease Owner W. E. Wickizer
Lease Name Hanna Well No. 1
Office Address Box 775, WaKeeney, Kansas
Character of Well (completed as Oil, Gas or Dry Hole) Dry Hole
Date well completed November 13, 1955
Application for plugging filed November 13, 1955
Application for plugging approved November 13, 1955
Plugging commenced November 13, 1955
Plugging completed November 13, 1955
Reason for abandonment of well or producing formation Dry

If a producing well is abandoned, date of last production 19
Was permission obtained from the Conservation Division or its agents before plugging was commenced? Yes

Name of Conservation Agent who supervised plugging of this well Eldon Petty
Producing formation Depth to top Bottom Total Depth of Well 4621 Feet
Show depth and thickness of all water, oil and gas formations.

OIL, GAS OR WATER RECORDS

CASING RECORD

Formation	Content	From	To	Size	Put In	Pulled Out

Describe in detail the manner in which the well was plugged, indicating where the mud fluid was placed and the method or methods used in introducing it into the hole. If cement or other plugs were used, state the character of same and depth placed, from feet to feet for each plug set.

Filled hole with heavy mud to 230', set plug, $\frac{1}{2}$ sack hulls, 15 sax cement, filled with mud to 40', plugged, $\frac{1}{2}$ sack hulls, 10 sax cement.
Total depth of well at this time was 4360', next day we decided to knock out the plug and drill deeper. We drilled to a total depth of 4621', called Eldon Petty and replugged the well in the same manner as described above.

RECEIVED
STATE CORPORATION COMMISSION
DEC 3 - 1955
CONSERVATION DIVISION
Wichita, Kansas


(If additional description is necessary, use BACK of this sheet)

Correspondence regarding this well should be addressed to W. E. Wickizer
Address Box 775, WaKeeney, Kansas

STATE OF Kansas, COUNTY OF Trego, ss.
W. E. Wickizer (employee of owner) or (owner & operator) of the above-described well,
being first duly sworn on oath, says: That I have knowledge of the facts, statements, and matters herein contained and the log of the above-described well as filed and that the same are true and correct. So help me God.

(Signature) *W. E. Wickizer*
(Address) *WaKeeney, K.*

SUBSCRIBED AND SWORN TO before me this 2nd day of December 19 55
Notary Public.

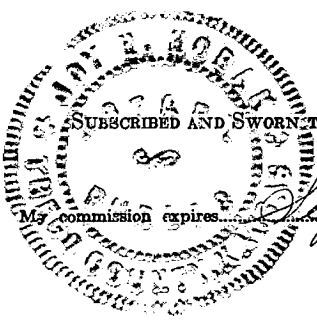

PLUGGING
FILE SEC 32 T 10 R 24E
BOOK PAGE 75 LINE 48
17 16

GOLDEN CAT DRILLING and SERVICING COMPANY

Office Phone 379

Residence Phone 350

P. O. Box 611

To State Corporation Commission

211 North Broadway

Wichita 2, Kansas

Well Hanna #1 (NW) Sec. ~~32~~ 30 Tw. 10 R. 24 Co. Graham
RTKCC

Exact Location (1320 ft. from North Line, 330 ft. from East Line)

Total Depth: 4621'

Date Commenced: October 24, 1955 Completed: November 13, 1955

Set 245' 8 5/8" surface pipe

245 to	820	Shale, sand and shells
820	1035	Shale and sand
1035	1530	Sand, pyrite and shale
1530	1565	Sand
1565	2138	Sand, red bed and shells
2138	2175	Anhydrite
2175	2530	Shale and shells
2530	2770	Shale and lime
2770	3020	Lime and shale
3020	3090	Sand
3090	3330	Lime and shale
3330	3605	Lime and shale
3605	3670	Lime
3670	3785	Lime and shale
3785	3858	Lime
3858	4012	Lime
4012	4175	Lime
4175	4220	Lime and shale
4220	4293	Lime
4293	4343	Lime and shale
4343	4360	Conglomerate
4360	4385	Mississippi chert
4385	4459	Lime and shale
4459	4579	Lime
4579	4621	Lime and chert
4621	TD	

PLUGGING
FILE SEC 30 T 10 R 24W
BOOK PAGE 17 LINE 16

REC'D
COMMISSION
DEC 14 1955
CONSERVATION DIVISION
Wichita, Kansas