


STATE OF KANSAS
STATE CORPORATION COMMISSION

Give All Information Completely
Make Required Affidavit
Mail or Deliver Report to:
Conservation Division
State Corporation Commission
212 North Market, Insurance Bldg.
Wichita, Kansas

WELL PLUGGING RECORD

NORTH

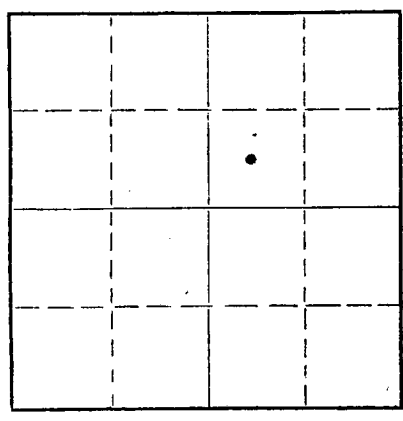

Locate well correctly on above
Section Plat

Graham County. Sec. 2 Twp. 10S Rge. 25 (~~W~~ ~~W~~)
Location as "NE/CNW/SW" or footage from lines CSW-NE
Lease Owner Amerada Petroleum Corporation
Lease Name M. Billinger Well No. 1
Office Address Box 197, Great Bend, Kansas
Character of Well (completed as Oil, Gas or Dry Hole) DRY HOLE
Date well completed 6-12- 1960
Application for plugging filed 6-12- 1960
Application for plugging approved 6-12- 1960
Plugging commenced 1:30 p.m. 6-12- 1960
Plugging completed 3:30 p.m. 6-12- 1960
Reason for abandonment of well or producing formation DRY

If a producing well is abandoned, date of last production -- 19--
Was permission obtained from the Conservation Division or its agents before plugging was commenced? Yes

Name of Conservation Agent who supervised plugging of this well Gilbert Leiker, Victoria, Kansas
Producing formation -- Depth to top -- Bottom -- Total Depth of Well 4080 Feet
Show depth and thickness of all water, oil and gas formations.

OIL, GAS OR WATER RECORDS

CASING RECORD

FORMATION	CONTENT	FROM	TO	SIZE	PUT IN	PULLED OUT
				8-5/8"	224'	None

Describe in detail the manner in which the well was plugged, indicating where the mud fluid was placed and the method or methods used in introducing it into the hole. If cement or other plugs were used, state the character of same and depth placed, from _____ feet to _____ feet for each plug set.

Spotted Cement Plugs Thru 4 1/2" DP As Follows:
600' to 540' W/20 Sacks Cement & 1 Sack Hulls
Filled W/Heavy Mud to 220'
220' to 160' W/20 Sacks Cement
Filled with heavy mud to 40'
40' to Top W/10 Sacks Cement

RECEIVED
STATE CORPORATION COMMISSION
6-23-1960
JUN 23 1960
CONSERVATION DIVISION
Wichita, Kansas

(If additional description is necessary, use BACK of this sheet)

Name of Plugging Contractor Peel Brothers Inc.
Address Hoisington, Kansas

STATE OF Kansas, COUNTY OF Barton, ss.
C.E. Richardson (employee of owner) of the above-described well, being first duly sworn on oath, says: That I have knowledge of the facts, statements, and matters herein contained and the log of the above-described well as filed and that the same are true and correct. So help me God.

(Signature) C.E. Richardson
Box 197, Great Bend, Kansas
(Address)

SUBSCRIBED AND SWORN TO before me this 13th day of June, 1960



Charles W. Anderson
Notary Public.

RECEIVED
STATE CORPORATION COMMISSION
6-23-1960
JUN 23 1960

DRILLERS' LOG

CONSULTING DIVISION
Wichita, Kansas

Well Owner: Amerada Petroleum Corporation
Well Name: Billinger Well No. 1
Total Depth: 4080'
Commenced: 6/2/60
Completed: 6/12/60
Casing: 8 5/8" @ 224' cement

C SW NE
Sec. 2, Twp. 10S, Rge. 25W
County, Graham,
Kansas
Elevation:

Contractor: Peel Brothers, Inc.

Production: Dry

Figures below indicate bottoms of formations:

Clay & sand	0-	110
Sand		170
Shale		960
Sand & shale		1970
Shale		2145
Red bed		2174
Anhydrite		2214
Shale & red bed		2270
Shale		2750
Lime & shale		2890
Shale		3000
Shale & lime		3470
Lime		4080
T.D.		4080

This is to certify that the above information is to the best of our knowledge, true and correct.

PEEL BROTHERS, INC.

BY Wendell E. Peel

SUBSCRIBED AND SWORN to before me this 15 day of June, 1960.

My commission expires: April 27, 1964

Luth Brant
Notary Public