


STATE OF KANSAS  
STATE CORPORATION COMMISSION

Give all Information Completely  
Make Required Affidavit  
Mail or Deliver Report to:  
Conservation Division  
State Corporation Commission  
800 Biting Building  
Wichita, Kansas

15-195-00310-00-00

WELL PLUGGING RECORD

NORTH

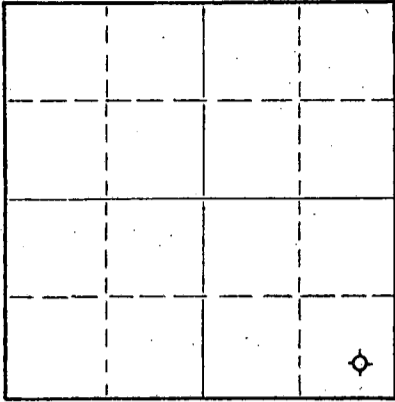

Locate well correctly on above  
Section Plat

TREGO County. Sec. 11 Twp. 12 Rge. 22W (E) W (W)  
Location as "NE/CNW/SW" or footage from lines SW SW SW  
Lease Owner C-G Drilling Co. & N. Appleman Co.  
Lease Name Nixon Well No. 1  
Office Address 107 Rule Building, Wichita, Kas.  
Character of Well (completed as Oil, Gas or Dry Hole) Dry Hole  
Date well completed 2-5 1955  
Application for plugging filed 2-5 1955  
Application for plugging approved 2-5 1955  
Plugging commenced 2-5 1955  
Plugging completed 2-5 1955  
Reason for abandonment of well or producing formation Too low structurally

If a producing well is abandoned, date of last production -- 19--  
Was permission obtained from the Conservation Division or its agents before plugging was commenced? Yes

Name of Conservation Agent who supervised plugging of this well Eldon Petty, Hays, Kansas  
Producing formation -- Depth to top -- Bottom -- Total Depth of Well 4063 Feet  
Show depth and thickness of all water, oil and gas formations.

OIL, GAS OR WATER RECORDS

CASING RECORD

FORMATION	CONTENT	FROM	TO	SIZE	PUT IN	PULLED OUT
				8-5/8"	186.50'	

Describe in detail the manner in which the well was plugged, indicating where the mud fluid was placed and the method or methods used in introducing it into the hole. If cement or other plugs were used, state the character of same and depth placed, from \_\_\_\_\_ feet to \_\_\_\_\_ feet for each plug set.

Filled hole with mud to 180'; set plug;  
1/2 sack hulls, 15 sacks cement. Filled  
hole with mud to 40'; set plug, then  
filled to top with 10 sacks cement, 1/2  
sack hulls.

(If additional description is necessary, use BACK of this sheet)

Name of Plugging Contractor C-G Drilling Co.  
Address 107 Rule Building, Wichita, Kansas

STATE OF KANSAS COUNTY OF SEDGWICK, ss.  
Vicky Jacobs

(employee of owner) or (owner or operator) of the above-described well, being first duly sworn on oath, says: That I have knowledge of the facts, statements, and matters herein contained and the log of the above-described well as filed and that the same are true and correct. So help me God.

(Signature) Vicky Jacobs  
Office Manager  
107 Rule Building, Wichita, Kansas  
(Address)

SUBSCRIBED AND SWORN to before me this 7th day of February, 1955

My commission expires June 17, 1957

Barbara J. ...  
Notary Public.  
STATE CORPORATION COMMISSION

**PLUGGING**  
ALL SEC. 11 T. 12 R. 22W  
BOOK PAGE 95 LINE 35

FEB - 8 1955  
02-08-1955  
CONSERVATION DIVISION  
Wichita, Kansas

15-195 - 00310-00-00

CONTRACTOR'S WELL LOG

OPERATOR C-G Drilling Co. & N. Appleman Co. FARM NAME Nixon Well #1

LOCATION SW SW SW, Section 11-12-22W

POOL NAME \_\_\_\_\_ COUNTY Trego STATE Kansas

COMMENCEMENT DATE January 25, 1955 COMPLETION DATE February 5, 1955

LOG OF WELL

Elevation: 2331 R.B.

All measurements from the top of rotary bushing.

FROM	TO	FORMATION	DEVIATION FROM VERTICAL	REMARKS:
0	186	Shale-Shells		
186	685	Shale-Shells		
685	1400	Shale-Shells-Sand		
1400	1768	Shale-Shells	0° - 1500	
1768	1811	Anhydrite		
1811	2000	Lime-Shale	0° - 2000	
2000	2235	Shale-Shells-Lime		
2235	2400	Lime-Shale		
2400	2550	Lime-Shale	0° - 2500	
2550	2690	Lime-Shale		
2690	2765	Lime-Shale		
2765	2950	Lime-Shale		
2950	3042	Lime-Shale	0° - 3000	
3042	3160	Lime-Shale		
3160	3285	Lime-Shale		
3285	3399	Lime-Shale		
3399	3500	Lime-Shale	0° - 3500	
3500	3560	Lime-Shale		
3560	3600	Lime-Shale		
3600	3645	Lime-Shale		
3645	3695	Lime-Shale		
3695	3750	Lime-Shale		
3750	3790	Lime-Shale		
3790	3845	Lime-Shale		
3845	3895	Lime-Shale		
3895	3941	Lime-Shale		
3941	3985	Lime-Shale		
3985	4008	Lime-Shale	0° - 4000	
4008	4042	Lime-Shale		
4042	4063	Lime-Shale		

CASING LEFT IN HOLE AFTER COMPLETION

Ran 186.50' of 8-5/8" Surface Casing.

STATE OF KANSAS, COUNTY OF SEDGWICK ) ss.

The undersigned certifies that to the best of her knowledge and belief, the above facts are true and correct.

C-G DRILLING CO.

BY *Vicky Jacobs*  
Office Manager

Subscribed and sworn to before me this 7th day of February, 1955.

My commission expires: June 17, 1957

*Barbara Donaldson*  
Notary Public

**PLUGGING**  
FILE SEC 11 T 12 R 22  
BOOK PAGE 95 LINE 35

FEB - 8 1955  
02-08-1955  
SERVATION DIVISION  
Wichita, Kansas