


15-195-20171-00-00

STATE OF KANSAS
STATE CORPORATION COMMISSION

Form CP-4

Give All Information Completely
Make Required Affidavit
Mail or Deliver Report to:
Conservation Division
State Corporation Commission
212 No. Market
Wichita, Kansas 67202

WELL PLUGGING RECORD

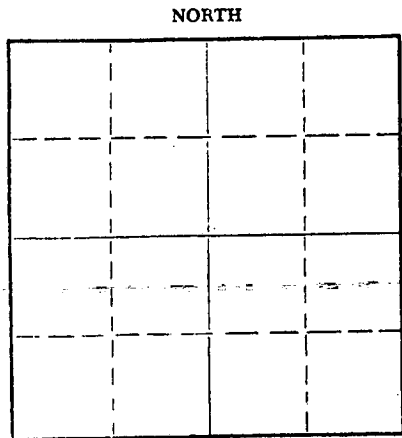

Locate well correctly on above
Section Plat

Trego County. Sec. 15 Twp. 12 Rge. 22 (E) W (W)
Location as "NE/CNWxSWx" or footage from lines. SE SW SW
Lease Owner Utica Southern Exploration, Inc.
Lease Name Olsen Well No. 1
Office Address 808 Palace Building, Tulsa, Oklahoma 74103
Character of Well (completed as Oil, Gas or Dry Hole) Dry Hole
Date well completed 1-6 1971
Application for plugging filed 1-6 1971
Application for plugging approved 1-6 1971
Plugging commenced 1-6 1971
Plugging completed 1-6 1971
Reason for abandonment of well or producing formation Dry Hole

If a producing well is abandoned, date of last production _____ 19____
Was permission obtained from the Conservation Division or its agents before plugging was commenced? Yes

Name of Conservation Agent who supervised plugging of this well Bill Nichols
Producing formation _____ Depth to top _____ Bottom _____ Total Depth of Well _____ Feet
Show depth and thickness of all water, oil and gas formations.

OIL, GAS OR WATER RECORDS

CASING RECORD

FORMATION	CONTENT	FROM	TO	SIZE	PUT IN	PULLED OUT
Surface Pipe				8 5/8"	227'	

Describe in detail the manner in which the well was plugged, indicating where the mud fluid was placed and the method or methods used in introducing it into the hole. If cement or other plugs were used, state the character of same and depth placed, from _____ feet to _____ feet for each plug set.

1st plug was set at 850' with 100 cu. ft.
2nd plug was set at 245' with 25 cu. ft.
3rd plug was set at 40' with 10 cu. ft.

RECEIVED
STATE CORPORATION COMMISSION
JAN 8 1971
CONSERVATION DIVISION
Wichita, Kansas
01-08-1971


(If additional description is necessary, use BACK of this sheet)

Name of Plugging Contractor L. J. Dreiling & Sons, Inc.
Address Victoria, Kansas 67671

STATE OF KANSAS, COUNTY OF ELLIS, ss.
I, Leo F. Dreiling (employee of owner) or (owner or operator) of the above-described well, being first duly sworn on oath, says: That I have knowledge of the facts, statements, and matters herein contained and the log of the above-described well is filed and that the same are true and correct. So help me God.

(Signature) Leo F. Dreiling
LEO F. DREILING, ROUTE 2, VICTORIA, KANSAS 67671
(Address)

Subscribed and Sworn to before me this 7th day of January, 19 71
September 19, 1974

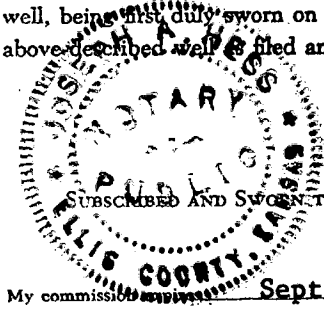

Joseph A. Hess
JOSEPH A. HESS
Notary Public.

L. J. DREILING AND SONS, INC.

Victoria, Kansas 67671

WELL LOG

15-195-20171-00-00

Company Utica Southern Exploration, Inc.
808 Palace Building
Tulsa, Oklahoma 74103

Sec. 15 Twp. 12 Rng. 22

Farm Olsen No. 1

Location SE SW SW

Total Depth 4095'

County Trego

Comm. 12-27-70 Comp. 1-6-71

Elevation: 2366' K. B.

Contractor L. J. Dreiling & Sons, Inc.
Victoria, Kansas 67671

2363' D. F.

2361' G. R.

Casing Record

Cement Record

Production:

227' - 8 5/8"

175 sacks cement

D & A

RECEIVED
STATE CORPORATION COMMISSION
JAN 8 1971
CONSERVATION DIVISION
Wichita, Kansas

Figures Indicate Bottom of Formations

0'	40'	Surface Soil & Rock
40'	70'	Sand
70'	90'	Sand Streaks & Shale
90'	228'	Shale
228'	710'	Shale
710'	790'	Sand
790'	850'	Shale
850'	1284'	Shale
1248'	1524'	Sand
1524'	1590'	Shale
1590'	1805'	Red Bed
1805'	1846'	Anhydrite
1846'	2345'	Shale
2345'	2555'	Shale & Lime
2555'	2740'	Lime & Shale
2740'	2910'	Lime & Shale
2910'	2960'	Shale & Lime Streaks
2960'	3150'	Shale & Lime
3150'	3335'	Lime & Shale
3335'	3550'	Lime & Shale
3550'	3600'	Lime
3600'	3607'	Lime
3607'	3680'	Lime & Shale
3680'	3700'	Lime
3700'	3730'	Lime
3730'	3750'	Lime
3750'	3770'	Lime
3770'	3828'	Lime
3828'	3915'	Lime
3915'	3988'	Lime
3988'	4050'	Lime
4050'	4085'	Lime with Shale Streaks
4085'	4095'	Lime & Shale
4095'	T.D.	

STATE OF KANSAS)

)ss

COUNTY OF ELLIS)

I, Leo F. Dreiling, of the L. J. Dreiling & Sons, Inc., upon oath states that the above and foregoing is a true and correct copy from the Daily Drilling Report from your Olsen #1.

Leo F. Dreiling
LEO F. DREILING

Subscribed and sworn to before me this 7th day of January, 1971.

Joseph A. Hess
JOSEPH A. HESS NOTARY PUBLIC

My commission expires: September 19, 1974

