


WELL PLUGGING RECORD

Give All Information Completely
Make Required Affidavit
Mail or Deliver Report to:
Conservation Division
State Corporation Commission
212 North Market, Insurance Bldg.
Wichita, Kansas

NORTH

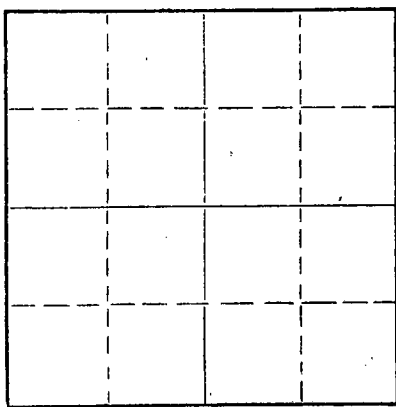

Locate well correctly on above
Section Plat

Trego County. Sec. 15 Twp. 12 Rge. (E)22 (W)
Location as "NE/CNW/SW" or footage from lines SW NE SE
Lease Owner Chief Drilling Co., Inc., ETAL
Lease Name Nixon Well No. 1
Office Address Box 97, Great Bend, Kansas
Character of Well (completed as Oil, Gas or Dry Hole) Dry Hole
Date well completed September 3 19 59
Application for plugging filed September 3 19 59
Application for plugging approved 19
Plugging commenced September 3 19 59
Plugging completed September 3 19 59
Reason for abandonment of well or producing formation Dry Hole

If a producing well is abandoned, date of last production 19
Was permission obtained from the Conservation Division or its agents before plugging was commenced? Yes

Name of Conservation Agent who supervised plugging of this well Gilbert P. Leiker, Victoria, Kansas
Producing formation Depth to top Bottom Total Depth of Well 4100 Feet
Show depth and thickness of all water, oil and gas formations.

OIL, GAS OR WATER RECORDS

CASING RECORD

FORMATION	CONTENT	FROM	TO	SIZE	PUT IN	PULLED OUT
				8 5/8"	239'	None

Describe in detail the manner in which the well was plugged, indicating where the mud fluid was placed and the method or methods used in introducing it into the hole. If cement or other plugs were used, state the character of same and depth placed, from feet to feet for each plug set.

/hulls
1/3 sacks, plug set @ 600'. Mixed
20 sacks cement through Drill Pipe.
1/3 sacks hulls, plug set @ 230'. Mixed
20 sacks cement through Drill Pipe.
1/3 sacks hulls, plug set @ 40'. Mixed
10 sacks cement.

RECEIVED
STATE CORPORATION COMMISSION
09-08-1959
SEP 8 1959

CONSERVATION DIVISION
Wichita, Kansas


(If additional description is necessary, use BACK of this sheet)
Name of Plugging Contractor Chief Drilling Co., Inc.
Address P. O. Box 97, Great Bend, Kansas

STATE OF Kansas COUNTY OF Barton, ss.
V. Richard Hoover, President (employee of owner) or (owner or operator) of the above-described well, being first duly sworn on oath, says: That I have knowledge of the facts, statements, and matters herein contained and the log of the above-described well as filed and that the same are true and correct. So help me God.

(Signature) *V. Richard Hoover*
P. O. Box 97, Great Bend, Kansas
(Address)

SUBSCRIBED AND SWORN TO before me this 4th day of September, 19 59

My commission expires June 1, 1963

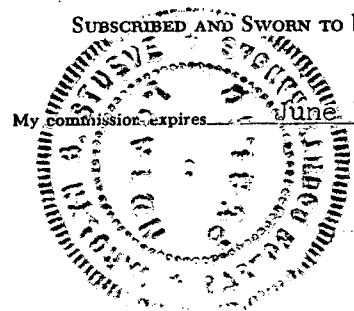

Carroll B. Stevens
Notary Public.

PLUGGING

File Sec. 15 T 12 R 22W
Book Page 2 Line 6

15-195-00097-00-00

W E L L L O G

SEP 8 1959
CONSERVATION DIVISION
Wichita, Kansas

Chief Drilling Co., Inc.
P. O. Box 97
Great Bend, Kansas

Nixon No. 1
SW NE SE Sec. 15-12-22
Trego County, Kansas

Contractor: Chief Drilling Co., Inc.
Torary : 0 to 4100' Total Depth

Commenced : August 24, 1959
Completed : September 3, 1959
Plugged and Abandoned

Casing Records: 8 5/8" set @ 240' with 175 sacks common cement. Cement circulated.

FORMATION	FROM	TO	FORMATION TOPS
Shale and shells	239	300	Anhydrite 1796 (+ 965)
Blue shale, shells and sand streaks	300	1250	Heebner 3628 (-1267)
Sand	1250	1265	Toronto 3646 (-1285)
Shale, shells and sand streaks	1265	1355	Lansing 3662 (-1301)
Sand	1355	1510	Marmaton Chert 3989 (-1628)
Shale and shells	1510	1620	Conglomerate 4029 (-1648)
Shale	1620	1796	Arbuckle 4086 (-1735)
Anhydrite	1796	1840	
Shale and lime streaks	1840	2290	
Shale and lime	2290	2445	
Lime with shale	2445	2565	
Lime and shale	2565	2830	
Shale and lime	2830	3255	
Lime and shale	3255	3545	
Lime	3545	3990	
Lime chert	3990	4030	
Conglomerate	4030	4086	
Dolomite	4086	4100	
Total Depth		4100'	

ELEVATION
2355' Gr.; 2358' D.F.; 2361' K.B.

DRILL STEM TESTS
DST #1 3664' to 3710'
Tool open 1 hour
Blow: Strong Throughout
Recovery: 825' Salt Water
IBHP-1290#; IFP-70#, FFP-520#,
FBHP-1205#

State of Kansas)
County of Barton) ss

I hereby certify that the above is a true and correct copy of the Driller's Log of the well drilled in the SW NE SE of Section 15, Township 12 South, Range 22 West, Trego County, Kansas to the best of my knowledge and belief.

CHIEF DRILLING COMPANY, INC.

V. Richard Hoover
V. Richard Hoover, President

Subscribed and sworn to before me this 4th day of September, 1959.

Carolyn E. Stueve
Carolyn E. Stueve, Notary Public

My Commission Expires: June 1, 1963

PLUGGING

File Sec. 15 T 12 R 22W
Book Page 2 Line 6

