


STATE OF KANSAS
STATE CORPORATION COMMISSION

WELL PLUGGING RECORD

Give All Information Completely
Make Required Affidavit
Mail or Deliver Report to:
Conservation Division
State Corporation Commission
800 Bitting Building
Wichita, Kansas

Trego _____ County, Sec. 17 Twp. 12S Rge. (E) 22 (W)
Location as "NE/CNW&SWK" or footage from lines SW SW NE
Lease Owner Rocket Drilling Company
Lease Name Rinker Well No. 1
Office Address 352 North Broadway, Wichita 2, Kansas
Character of Well (completed as Oil, Gas or Dry Hole) Dry Hole
Date well completed May 19, 19 53
Application for plugging filed May 19, (Oral) 19 53
Application for plugging approved May 20, 19 53
Plugging commenced May 19, 19 53
Plugging completed May 19, 19 53
Reason for abandonment of well or producing formation ---

NORTH

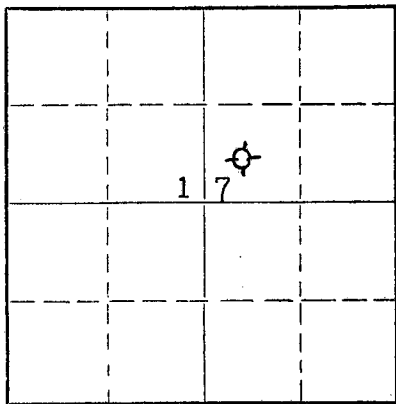

Locate well correctly on above
Section Plat

If a producing well is abandoned, date of last production --- 19
Was permission obtained from the Conservation Division or its agents before plugging was commenced? Yes

Name of Conservation Agent who supervised plugging of this well Eldon Petty, Box 326, Hays, Kansas
Producing formation _____ Depth to top _____ Bottom _____ Total Depth of Well 4162 Feet
Show depth and thickness of all water, oil and gas formations.

OIL, GAS OR WATER RECORDS

CASING RECORD

FORMATION	CONTENT	FROM	TO	SIZE	PUT IN	PULLED OUT
				8-5/8	194'	None

Describe in detail the manner in which the well was plugged, indicating where the mud fluid was placed and the method or methods used in introducing it into the hole. If cement or other plugs were used, state the character of same and depth placed, from _____ feet to _____ feet for each plug set.

Filled hole with mud to 194'. Set plug and cemented with 15 sacks. Filled hole with mud to 40'. Set plug and cemented with 10 sacks.

RECEIVED
STATE CORPORATION COMMISSION
MAY 26 1953
05-26-1953
CONSERVATION DIVISION
Wichita, Kansas

(If additional description is necessary, use BACK of this sheet)
Name of Plugging Contractor Rocket Drilling Company
Address 352 North Broadway, Wichita 2, Kansas

STATE OF Kansas, COUNTY OF Sedgwick, ss.
B. W. Burks (employee of owner) of the above-described

well, being first duly sworn on oath, says: That I have knowledge of the facts, statements, and matters herein contained and the log of the above-described well as filed and that the same are true and correct. So help me God.

(Signature) B. W. Burks
352 North Broadway, Wichita 2, Kansas
(Address)

SUBSCRIBED AND SWORN to before me this 22nd day of May, 19 53

My commission expires 12-3-55

Barbara Newby
Notary Public.

PLUGGING
FILE SEC 17 T 12 R 224
BOOK PAGE 102 LINE 24

ROCKET DRILLING COMPANY
 352 North Broadway
 Wichita 2, Kansas

Rocket Drilling Company, Etal
 352 North Broadway
 Wichita, Kansas

#1 Rinker
 SW SW NE; 17-12-22W
 Trego County, Kansas

Elevation: 2387 R.B.
 Spudded: May 8, 1953
 Rotary Completed: May 19, 1953
 Cable Tools Completed: None
 Acid Treatment: None
 Initial Production: Dry & Abandoned
 Contractor: Rocket Drilling Company

CASING RECORD

194" 8-5/8" O. D. 24# Seamless Casing Cemented W/130 Sacks Cement.
 5-1/2" None.

DRILLERS LOG

Shale	0 to 35	Shale	2735 to 2745
Sand	80	Sand	2770
Shale & Shells	640	Lime	3200
Sand	700	Shale	3255
Shale	712	Lime & Shale	3365
Sand	730	Shale & Lime	3460
Shale & Sand	1565	Lime	3923
Red Shale	1809	Lime & Shale	3974
Anhydrite	1868	Lime	4023
Shale	2030	Lime & Chert	4057
Shale, Shells & Salt	2325	Lime & Shale	4107
Shale & Lime	2715	Chert & Lime	4128
Sand	2730	Arbuckle Lime	4162 TD
Lime	2735		

RECORDED
 STATE CORPORATION COMMISSION

STATE OF KANSAS)
 SEDGWICK COUNTY) SS:

MAY 26 1953
 05-26-1953
 CONSERVATION DIVISION
 Wichita, Kansas

I hereby certify that to the best of my knowledge and belief,
 the foregoing log is true and correct.

PLUGGING

FILE SEC 17 T 12 R 224
 BOOK PAGE 102 LINE 24

ROCKET DRILLING COMPANY

By [Signature]

Subscribed and sworn to before me, a Notary Public, in and for
 the State and County aforesaid this 22nd day of May, 1953.

My Commission Expires: 12-3-55

[Signature]
 Notary Public