

15-065-20345-0000

STATE OF KANSAS
STATE CORPORATION COMMISSION

Form CP-4

Give All Information Completely
Make Required Affidavit
Mail or Deliver Report to:
Conservation Division
State Corporation Commission
212 No. Market
Wichita, Kansas 67202

WELL PLUGGING RECORD

Graham County, Sec. 25 Twp. 10S Rge. (E) 24 (W)

Location as "NE/CNW/SW" or footage from lines NE NE SW

Lease Owner Rains & Williamson Oil Co., Inc.

Lease Name Billings Well No. 1

Office Address 1425 Wichita Plaza, Wichita, Kansas

Character of Well (completed as Oil, Gas or Dry Hole) Dry Hole

Date well completed 7-4 19 70

Application for plugging filed 7-4 19 70

Application for plugging approved 7-4 19 70


Plugging commenced 7-4 19 70

Plugging completed 7-4 19 70

Reason for abandonment of well or producing formation No oil or gas found in commercial quantities.

If a producing well is abandoned, date of last production -- 19 --

Was permission obtained from the Conservation Division or its agents before plugging was commenced? Yes

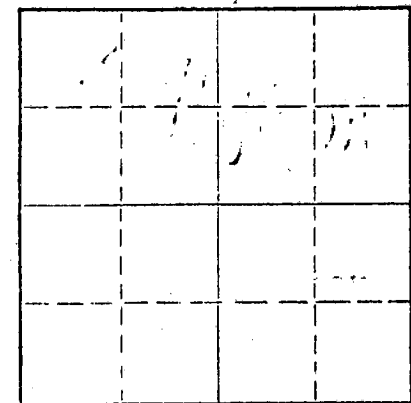

Locate well correctly on above Section Plat

Name of Conservation Agent who supervised plugging of this well Leo Massey, Hays, Kansas

Producing formation _____ Depth to top _____ Bottom _____ Total Depth of Well 4010 Feet

Show depth and thickness of all water, oil and gas formations.

OIL, GAS OR WATER RECORDS

CASING RECORD

FORMATION	CONTENT	FROM	TO	SIZE	PUT IN	PULLED OUT
				8-5/8"	217'	-0-

Describe in detail the manner in which the well was plugged, indicating where the mud fluid was placed and the method or methods used in introducing it into the hole. If cement or other plugs were used, state the character of same and depth placed, from _____ feet to _____ feet for each plug set.

Set first plug at 950' with 70 sacks; second plug at 210' with 20 sacks; top plug at 40' with 10 sacks. Solid bridge to surface. Plugging completed at 2:30 p.m. 7-4-70.

(If additional description is necessary, use BACK of this sheet)

Name of Plugging Contractor Rains & Williamson Oil Co., Inc.

Address 1425 Wichita Plaza, Wichita, Kansas

STATE OF KANSAS, COUNTY OF SEDGWICK, ss. Wilson Rains (employee of owner) or (owner or operator) of the above-described well, being first duly sworn on oath, says: That I have knowledge of the facts, statements, and matters herein contained and the log of the above-described well as filed and that the same are true and correct. So help me God.

(Signature) Wilson Rains
1425 Wichita Plaza, Wichita, Kansas (Address)

Subscribed and sworn to before me this 10 day of July, 19 70



Jeanine Durand Notary Public

ROTARY DRILLING LOG

Operator: Rains & Williamson
Oil Co., Inc.
BILLINGS #1
NE NE SW Sec. 25-10S-24W
Graham County, Kansas

Contractor: Rains & Williamson
Oil Co., Inc.
Commenced: 6-27-70
Completed: 7-4-70
Casing: 8-5/8"/217'/170 sacks

Formations

Shale and Shells	730'
Shale and Sand	1370'
Sand and Shale	2024'
Anhydrite	2065'
Shale	2115'
Shale and Lime	2755'
Lime and Shale	3770'
Lime	4010'
Rotary Total Depth	4010'

RECEIVED
STATE CORPORATION COMMISSION
JUL 13 1970
CONSERVATION DIVISION
Wichita, Kansas

We certify the above log is true and correct, to the best of our knowledge and belief.

RAINS & WILLIAMSON OIL CO., INC.

Wilson Rains

Wilson Rains

Subscribed and sworn to before me, a Notary Public within and for the State of Kansas, County of Sedgwick, this 10 day of July, 1970.

Jeanine Durand

Jeanine Durand Notary Public



My Commission Expires: 3-31-74