

15-065-20173-0000

STATE OF KANSAS
STATE CORPORATION COMMISSION

Form CP-4


WELL PLUGGING RECORD

Give All Information Completely
Make Required Affidavit
Mail or Deliver Report to:
Conservation Division
State Corporation Commission
212 No. Market
Wichita, Kansas

Graham County, Sec. 25 Twp. 10S Rge. (E) 24 (W)

Location as "NE/CNW%SW%" or footage from lines NE SW NE
Lease Owner Halliburton Oil Producing Company
Lease Name Mabelle Well No. 1
Office Address 520 Cameron Building, Oklahoma City, Okla
Character of Well (completed as Oil, Gas or Dry Hole) Dry Hole
Date well completed 10-17 1968
Application for plugging filed 10-17 1968
Application for plugging approved 10-17 1968
Plugging commenced 10-17 1968
Plugging completed 10-17 1968
Reason for abandonment of well or producing formation Dry Hole

NORTH

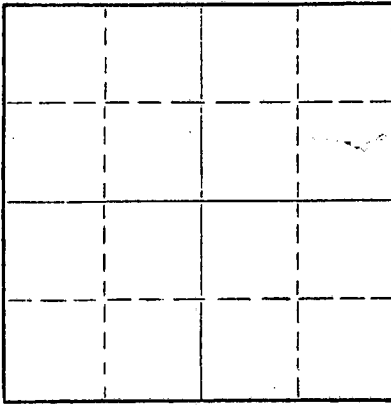

Locate well correctly on above
Section Plat

If a producing well is abandoned, date of last production 19
Was permission obtained from the Conservation Division or its agents before plugging was commenced? Yes

Name of Conservation Agent who supervised plugging of this well W. L. Nichols
Producing formation Depth to top Bottom Total Depth of Well 3955 Feet
Show depth and thickness of all water, oil and gas formations.

OIL, GAS OR WATER RECORDS

CASING RECORD

FORMATION	CONTENT	FROM	TO	SIZE	PUT IN	PULLED OUT
				8 5/8"	250'	

Describe in detail the manner in which the well was plugged, indicating where the mud fluid was placed and the method or methods used in introducing it into the hole. If cement or other plugs were used, state the character of same and depth placed, from feet to feet for each plug set.

Plugged with 100 cubic feet 50/50 Posmix 6% Gel @ 1050'
Plugged with 25 cubic feet 50/50 Posmix 6% Gel @ 275'
Plugged with 10 cubic feet 50/50 Posmix 6% Gel @ 40'

RECEIVED
STATE CORPORATION COMMISSION
OCT 23 1968
CONSERVATION DIVISION
Wichita, Kansas

(If additional description is necessary, use BACK of this sheet)
Name of Plugging Contractor Leben Drilling, Inc.
Address Box 486, Great Bend, Kansas

STATE OF KANSAS, COUNTY OF BARTON, ss.
Leslie Kite (employee of owner) or (owner or operator) of the above-described well, being first duly sworn on oath, says: That I have knowledge of the facts, statements, and matters herein contained and the log of the above-described well as filed and that the same are true and correct. So help me God.


(Signature) Leslie Kite

(Address)

Subscribed and sworn to before me this 21st day of October, 1968

My commission expires April 1, 1971

Ulanda Nichols
Notary Public.

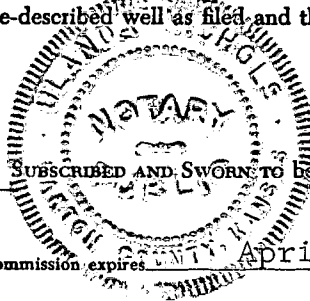

DRILLER'S LOG

COMPANY	Halliburton Oil Producing Company
CONTRACTOR	LEBEN DRILLING, INC.
FARM	MABELLE #1
LOCATION	NE SW NE SECTION 25-10S-24W GRAHAM COUNTY, KANSAS
COMMENCED	10-10-68
COMPLETED	10-17-68

0	50	Post Rock
50	910	Shale
910	1250	Sand, Shale
1250	1325	Sand
1325	1505	Shale
1505	1735	Shale, Sand
1735	1930	Shale
1930	1976	Red Bed
1976	2020	Anhydrite
2020	2355	Red Bed, Shale
2355	2400	Shale, Red Bed
2400	2605	Shale
2605	3600	Lime, Shale
3600	3955	Lime
	<u>3955</u>	<u>RTD - D. & A.</u>

RECEIVED
STATE CORPORATION COMMISSION
OCT 23 1968
CONSERVATION DIVISION
Wichita, Kansas

8 5/8" 20# new surface casing set @ 250' cemented with 175 sacks
60/40 HA5

I, Leslie Kite, do hereby certify that the above and foregoing is a true and correct copy of the log of the Mabelle #1 Well, located NE SW NE of Section 25, Township 10 South, Range 24 West, Graham County, Kansas, as reflected by the records of Leben Drilling, Inc.

Leslie Kite
Leslie Kite

STATE OF KANSAS)
) SS
COUNTY OF BARTON)

Subscribed and sworn to and before me, a Notary Public, in and for Barton County, Kansas, this 21st day of October, 1968.

Ulanda Nichols
Ulanda Nichols



Expires: