


Give All Information Completely
Make Required Affidavit
Mail or Deliver Report to:
Conservation Division
State Corporation Commission
211 No. Broadway
Wichita, Kansas

WELL PLUGGING RECORD

Trego County, Sec. 12 Twp. 12S Rge. 22W (EX) (W)

Location as "NE/CNW/SW" or footage from lines SW SW SE
Lease Owner D. R. Lauck Oil Company, Inc.
Lease Name Sherfick Well No. 1
Office Address 301 S. Broadway, Wichita, Kansas
Character of Well (completed as Oil, Gas or Dry Hole) Dry Hole
Date well completed October 21, 1963
Application for plugging filed October 21, 1963
Application for plugging approved October 21, 1963
Plugging commenced October 21, 1963
Plugging completed October 21, 1963
Reason for abandonment of well or producing formation Dry Hole

NORTH

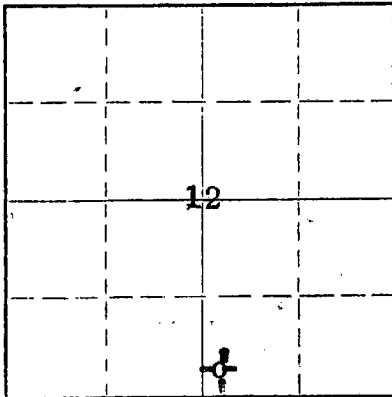

Locate well correctly on above
Section Plat

If a producing well is abandoned, date of last production 19____
Was permission obtained from the Conservation Division or its agents before plugging was commenced? Yes

Name of Conservation Agent who supervised plugging of this well W. L. Nichols
Producing formation _____ Depth to top _____ Bottom _____ Total Depth of Well 4095 Feet
Show depth and thickness of all water, oil and gas formations.

OIL, GAS OR WATER RECORDS

CASING RECORD

FORMATION	CONTENT	FROM	TO	SIZE	PUT IN	PULLED OUT
		0'	213'	8-5/8"	213'	None

Describe in detail the manner in which the well was plugged, indicating where the mud fluid was placed and the method or methods used in introducing it into the hole. If cement or other plugs were used, state the character of same and depth placed, from _____ feet to _____ feet for each plug set.

4095'-600' Mud
600'-596' Plug
596'-556' Cement, 20 sacks
556'-200' Mud
200'-196' Plug
196'-156' Cement, 20 sacks
156'-35' Mud
35'-31' Plug
31'-6' Cement, 10 sacks (Bottom of Cellar)

RECEIVED
STATE CORPORATION COMMISSION

NOV 8 1963

11-08-1963
CONSERVATION DIVISION
Wichita, Kansas

(If additional description is necessary, use BACK of this sheet)
Name of Plugging Contractor Halliburton Oil Well Cementing Co.
Address Great Bend, Kansas

STATE OF KANSAS, COUNTY OF SEDGWICK, ss.
John H. Knightley (employee of owner) or (owner or operator) of the above-described well, being first duly sworn on oath, says: That I have knowledge of the facts, statements, and matters herein contained and the log of the above-described well as filed and that the same are true and correct. So help me God.

(Signature) John H. Knightley
301 S. Broadway, Wichita, Kansas
(Address)

SUBSCRIBED AND SWORN to before me this 4th day of November, 1963

March 12, 1967

Notary Public.

D. R. LAUCK OIL COMPANY, INC.

Sherfick #1

15-195 - 00488-00-00
SW SW SE Sec. 12-12S-22W
Trego County, Kansas

Commenced: October 11, 1963

Completed: October 21, 1963

Casing Record: 213' 8-5/8" Cemented w/160 sacks Cement,
3 sacks Calcium Chloride.

Elevation: GL 2339; DF 2341; KB 2343.

Drillers Log

Tops

Surface Clay	45
Shale	213
Shale & Sand	920
Sand	1100
Shale	1250
Red Bed	1310
Sand	1500
Shale, Red Bed & Shells	1788
Anhydrite	1810
Shale & Shells	2330
Shale & Lime	2760
Lime & Shale	3015
Shale & Lime	3135
Lime & Shale	3295
Shale & Lime	3390
Lime & Shale	3430
Shale & Lime	3610
Lime & Shale	3709
Lime	3875
Lime & Shale	3940
Lime & Chert	3996
Shale, Lime, Chert	4035
Lime & Chert	4055
Lime	4095 RTD

	Sample	Schlumberger
Heebner	3612-1269	3612-1269
Toronto	3632-1289	3632-1289
Lansing	3645-1302	3646-1303
Base Kansas City	3879-1536	3878-1535
Marmaton	3964-1621	3962-1619
Conglomerate	4016-1673	4018-1675
Arbuckle	4056-1713	4055-1712
Total Depth	4095-1752	4096-1753

DST #1 (W) 3673-3709, open 1 hr. w/strong
blow. Recovered 1175' salt water.
ISIP 1484#/30 min.
FSIP 1276#/30 min.
IFP 133#
FFP 602#

DST #2 (W) 3726-3746, open 1 hr. w/weak
increasing to fair blow. Recovered
480' salt water.
ISIP 1332#/30 min.
FSIP 1300#/30 min.
IFP 39#
FFP 287#

DST #3 (W) 3972-3996, open 92 min. w/weak
blow 10 min. Flush, no help. Recovered
15' slightly oil cut mud.
ISIP 1260#/30 min.
FSIP 1054#/54 min.
IFP 31#
FFP 53#

DST #4 (W) 4059-4070, open 1 hr. w/weak
steady blow. Recovered 120' muddy
water.
ISIP 1149#/30 min.
FSIP 801#/30 min.
IFP 23#
FFP 78#

RECEIVED
STATE CORPORATION COMMISSION

NOV 8 1963
11-08-1963
CONSERVATION DIVISION
Wichita, Kansas