

STATE OF KANSAS
STATE CORPORATION COMMISSION
130 S. Market, Room 2078
Wichita, KS 67202

WELL PLUGGING RECORD
K.A.R.-82-3-117

15-065-03198-00-00
15-SS

API NUMBER

LEASE NAME DIEBOLT UNIT

WELL NUMBER 11-6

TYPE OR PRINT
NOTICE: Fill out completely and return
to Cons. Div. office within 30 days.

2970 Ft. from S/N Line of Section (circle one)

2970 Ft. from E/W Line of Section (circle one)

LEASE OPERATOR MANTA PETROLEUM INC.

SPOT LOCATION SE - SE - NW -

ADDRESS P.O. Box 4491

SEC. 28 TWP. 10 S. RGE 23 (E) or (W)

CITY, STATE, ZIP ENGLEWOOD CO 80155

COUNTY GRAHAM

PHONE#(363) 7997828 OPERATORS LICENSE NO. 31638

Date Well Completed 01/1955

Character of Well OIL

Date Plugging Commenced 07/30/96

(Oil, Gas, D&A, SWD, Input, Water Supply Well)

Date Plugging Completed 07/30/96

The plugging proposal was approved on 07/15/96 (date)

by CARL GOODROW (KCC District Agent's Name)

Is ACO-1 filed? No If not, is well log attached? No

Producing Formation(s) LANSING Depth to Top 3812 Bottom 3824 T.D. 3879

Show depth and thickness of all water, oil and gas formations.

OIL, GAS OR WATER RECORDS

CASING RECORD

FORMATION	CONTENT	FROM	TO	SIZE	PUT IN	PULL OUT
LANSING	OIL & WATER					
		SURFACE	240	8 5/8"	240	0
		SURFACE	3879	5 1/2"	3879	0

Described in detail the manner in which the well was plugged, indicating where the mud fluid was placed and the method or methods used in introducing it into the hole. If cement or other plugs were used, state the character of same and depth placed, from _____ feet to _____ feet each set.

SQUEEZED 5 1/2" WITH 325 SXS OF CEMENT BLEND WITH 500# HULLS
MIXED IN. MAX. SQUEEZE PRESSURE WAS 600 PSI. SQUEEZED 8 5/8"
WITH 50 SXS CEMENT BLEND TO MAX PRESSURE OF 50 PSI

(If additional description is necessary, use BACK of this form.)

Name of Plugging Contractor ALLIED CEMENT COMPANY

License No. N/A

Address 24 S. LINCOLN, P.O. Box 31, RUSSELL, KS

NAME OF PARTY RESPONSIBLE FOR PLUGGING FEES: MANTA PETROLEUM INC.

STATE OF Colorado COUNTY OF Arapahoe, ss.

STEVE BECKLEY

(Employee of Operator or (Operator) of above-described well on being first

duly sworn on oath, says: That I have knowledge of the facts, statements, and matters herein contained and the log of the above-described well as filed that the same are true and correct, so help me God.

(Signature) [Signature]

(Address) P.O. Box 4491, Englewood CO 80155


SUBSCRIBED AND SWORN TO before me this 14th day of August, 1996

[Signature]
Notary Public

My Commission Expires: 2/13/1999

RECEIVED
KANSAS CORPORATION COMMISSION

8-16-1996
AUG 16 1996

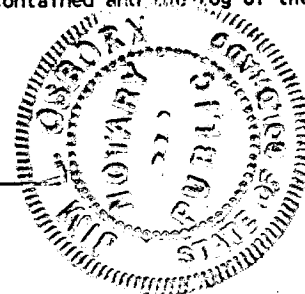

15-065-03198-00-00

WELL COMPLETION SKETCHES SUN-5036-4-A

WELL Diebolt 11-6	FIELD Diebolt, KS	DATE 4-15-87
-------------------	-------------------	--------------

☒ PRESENT COMPLETION☐ SUGGESTED COMPLETION

PERMANENT WELL BORE DATA

DATA ON THIS COMPLETION

8 5/8" 22.7# @ 240'

w/165 sx cmt.

KB 2373'

SE SE ^{NW} SW 28-10S-23W

Stage collar @ 1982'

circ. w/Ken-Pac to top.

5 1/2" 14# @ 3879'

w/125 sx cmt.

just tied
in pump out.


Perfs:

J 3812-24' w/48 holes

K 3838-45' w/28 holes

Flow collar @ 3851'

TD 3880'

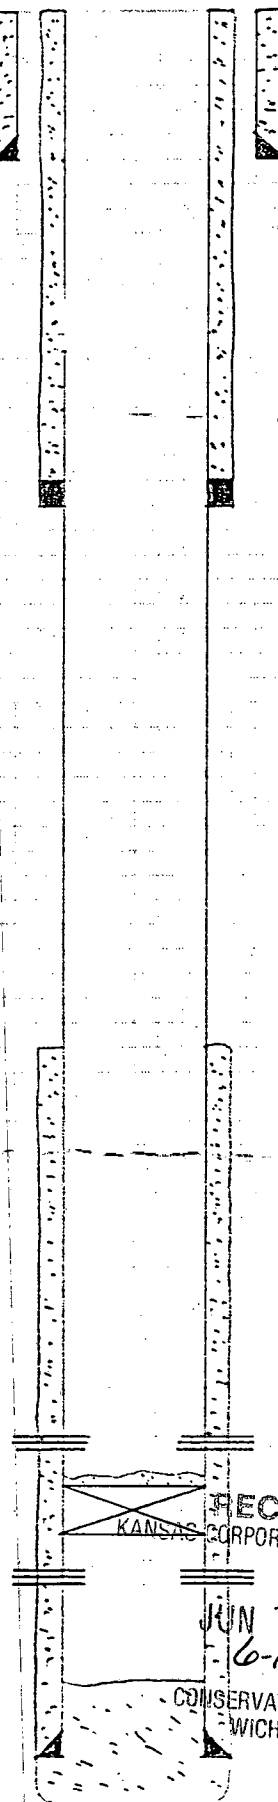

RECEIVED CIBP @ 3834' w/1 sx
KANSAS CORPORATION COMMISSION
cmt. Alled to 3830'


JUN 10 1996
6-10-1996

CONSERVATION DIVISION
WICHITA, KS

S. Peterson

- DIEBOLT LKC UNIT #11-6

15-065-03198-00-00

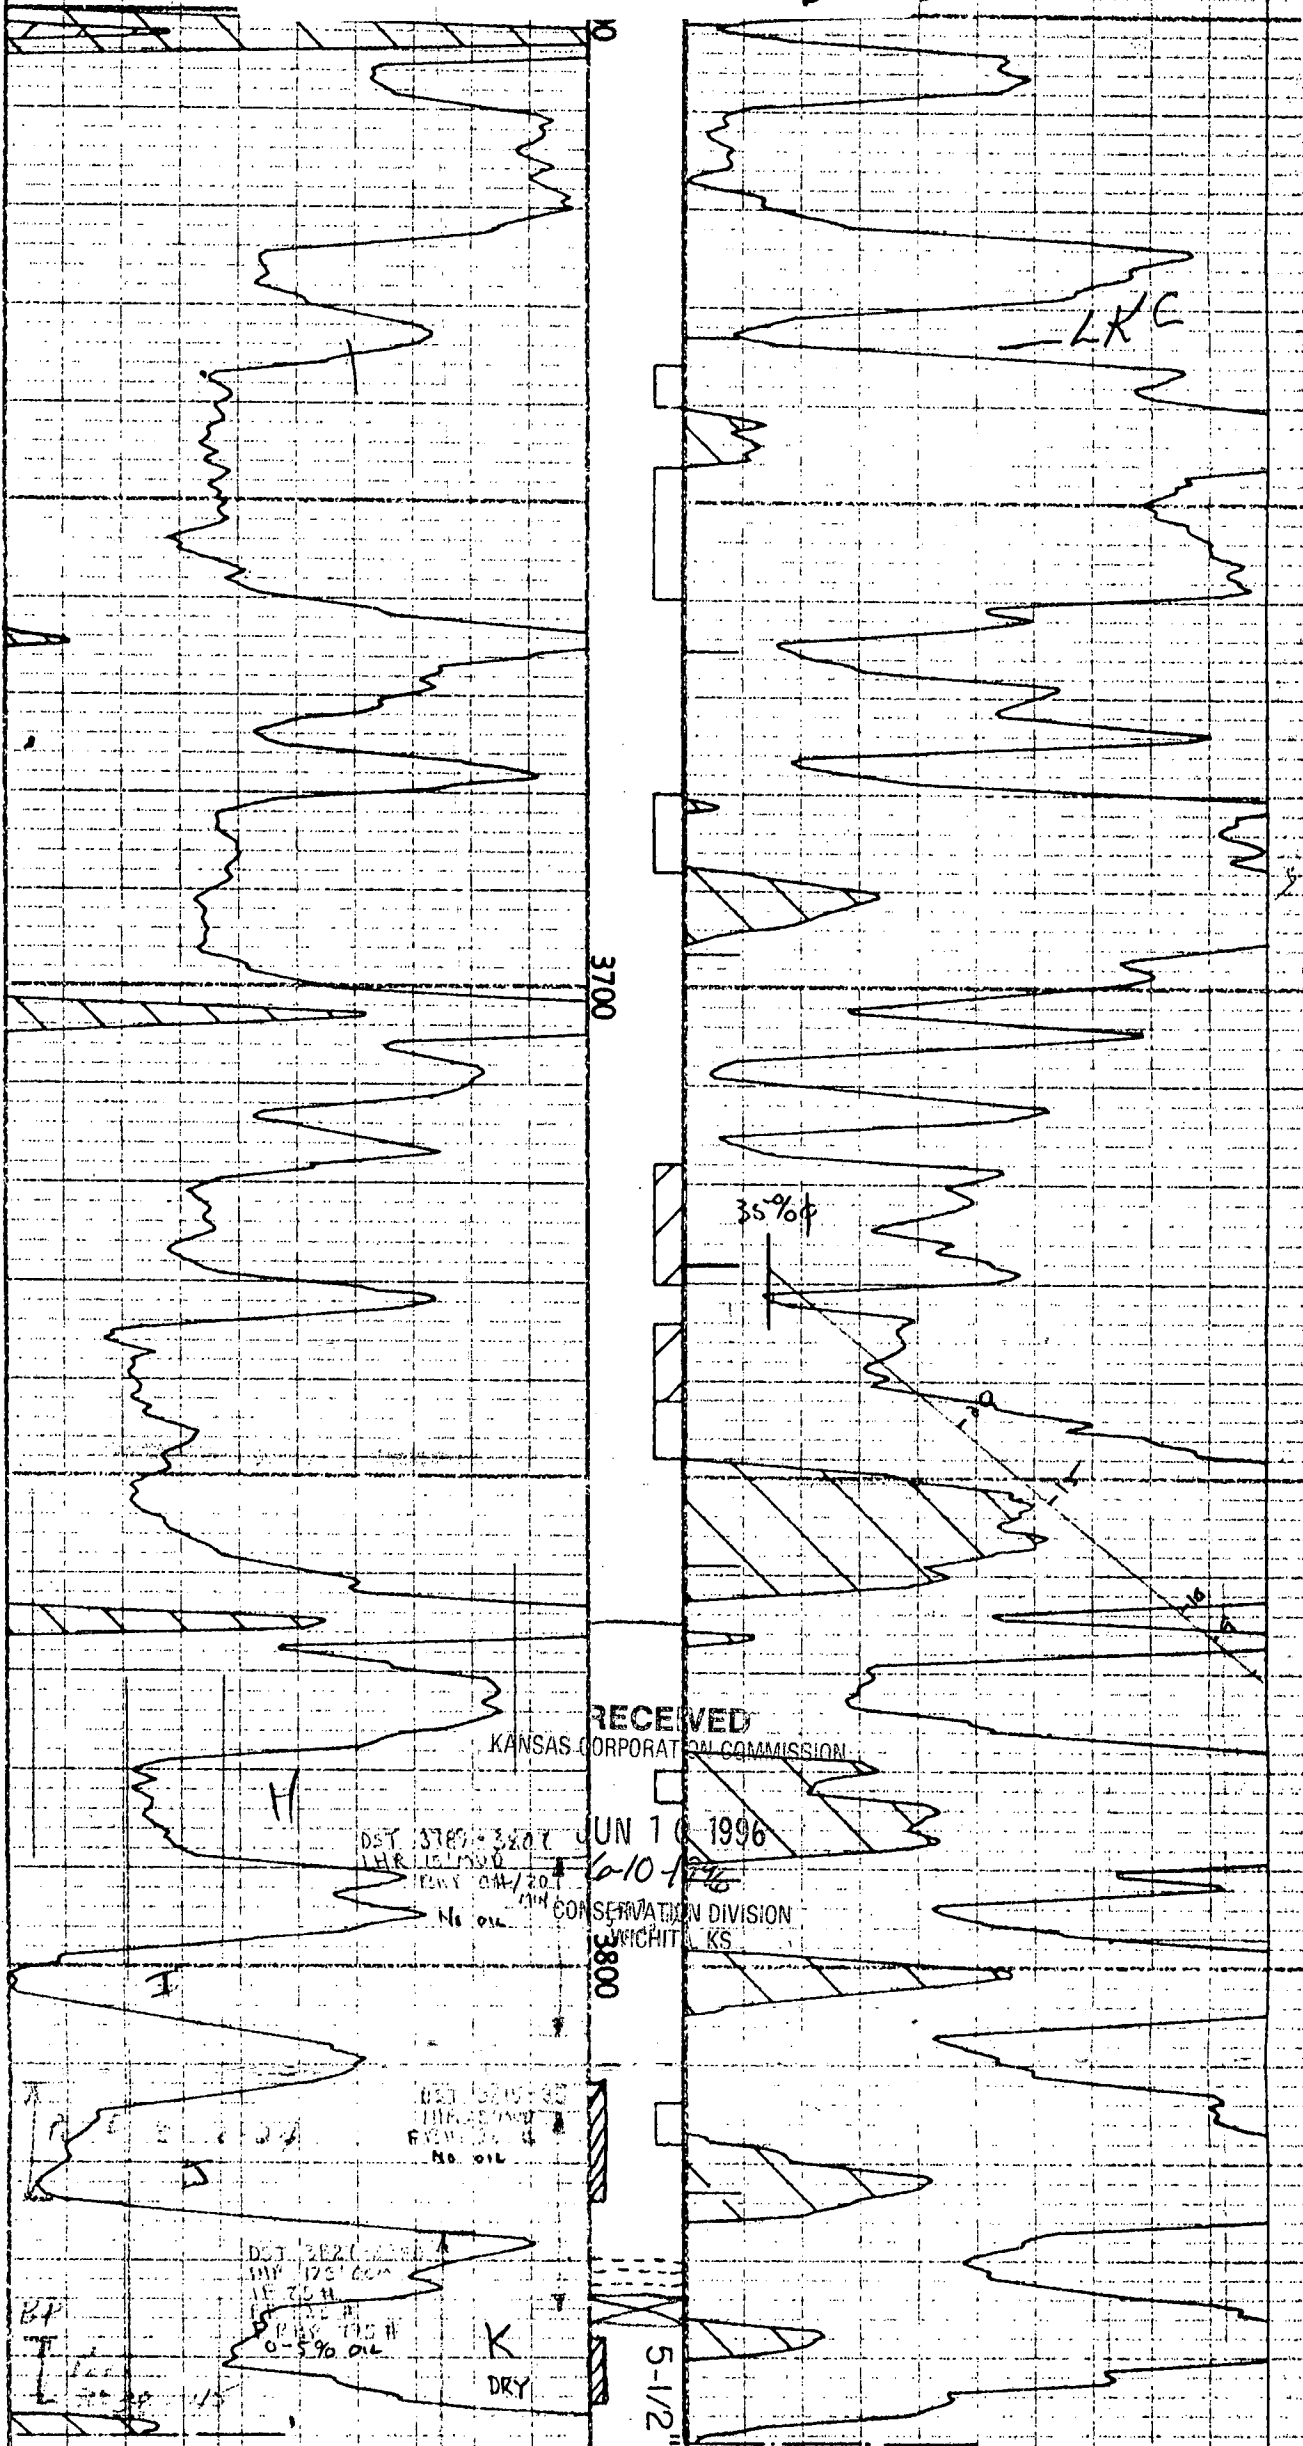

R.D. - 3848

R.D. - 3849
T.D. - 3851

LARIO OIL & GAS CO.

WTR