


STATE OF KANSAS
STATE CORPORATION COMMISSION

Form CP-4

Give All Information Completely
Make Required Affidavit
Mail or Deliver Report to:
Conservation Division
State Corporation Commission
212 No. Market
Wichita, Kansas

WELL PLUGGING RECORD

NORTH

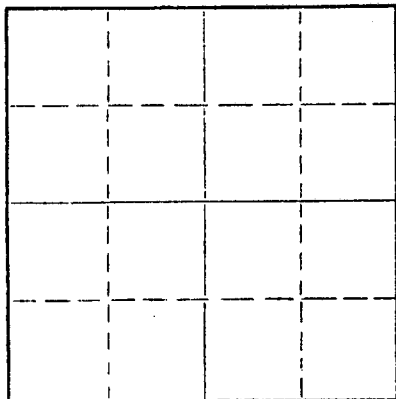Locate well correctly on above
Section Plat

Edwards County, Sec. 33 Twp. 26S Rge. 20 (X) (W)
Location as "NE/CNW/SW" or footage from lines C NW NE
Lease Owner Mull Drilling Company & Walters Drilling Co.
Lease Name Robbins 'B' Well No. 1
Office Address 1625 Wichita Plaza Building - Wichita, Kansas
Character of Well (completed as Oil, Gas or Dry Hole) Dry Hole
Date well completed 9-27-67 19
Application for plugging filed 9-27-67 19
Application for plugging approved 9-27-67 19
Plugging commenced 9-27-67 19
Plugging completed 9-27-67 19
Reason for abandonment of well or producing formation commercial quantities of oil not found
If a producing well is abandoned, date of last production 19
Was permission obtained from the Conservation Division or its agents before plugging was commenced? yes

Name of Conservation Agent who supervised plugging of this well Archie Elving
Producing formation Depth to top Bottom Total Depth of Well 4906 Feet
Show depth and thickness of all water, oil and gas formations.

OIL, GAS OR WATER RECORDS

CASING RECORD

FORMATION	CONTENT	FROM	TO	SIZE	PUT IN	PULLED OUT
				8 5/8"	567'	None

Describe in detail the manner in which the well was plugged, indicating where the mud fluid was placed and the method or methods used in introducing it into the hole. If cement or other plugs were used, state the character of same and depth placed, from feet to feet for each plug set.

Bottom Plug @ 400' w/ 25 sacks cement.
Top Plug @ 40' w/ 10 sacks cement.
2 sacks cement for rathole

RECEIVED
STATE CORPORATION COMMISSION

OCT - 3 1967

CONSERVATION DIVISION
Wichita, Kansas

(If additional description is necessary, use BACK of this sheet)

Name of Plugging Contractor Walters Drilling Co.
Address 400 Insurance Building - Wichita, Kansas

STATE OF KANSAS, COUNTY OF SEDGWICK, ss.
Robert F. Walters (employee or owner or operator) of the above-described well, being first duly sworn on oath, says: That I have knowledge of the facts, statements, and matters herein contained and the log of the above-described well as filed and that the same are true and correct. So help me God.

(Signature)


400 Insurance Building - Wichita, Kansas

(Address)

3rd day of October, 19 67

Juanita M. Green

Notary Public.

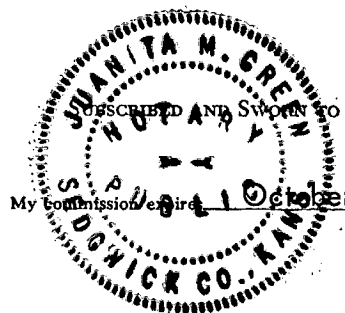

DRILLER'S LOG

COMPANY:

MULL DRILLING CO., & WALTERS DRILLING CO.
1625 WICHITA PLAZA BUILDING
WICHITA, KANSAS

WELL NAME:

ROBBINS 'B' #1
C NW NE SECTION 33-26S-20W
EDWARDS COUNTY, KANSAS

CONTRACTOR:

WALTERS DRILLING CO.
400 INSURANCE BUILDING
WICHITA, KANSAS

ROTARY DRILLING COMMENCED:

SEPTEMBER 16, 1967

ROTARY DRILLING COMPLETED:

SEPTEMBER 27, 1967

ELEVATION:

2265 KB

CASING RECORD:

8 5/8" @ 567' w/ 275 sacks cement

LOG

0 - 130	Sand
130 - 569	Shale
569 - 702	Shale and Sand
702 - 720	Blaine Anhydrite
720 - 1703	Shale
1703 - 2102	Shale and Lime
2102 - 2230	Shale
2230 - 2514	Lime and Shale
2514 - 2684	Shale and Lime Streaks
2684 - 2836	Lime and Shale
2836 - 2990	Lime and Shale
2990 - 3204	Sandy Shale and Lime
3204 - 4167	Shale and Lime
4167 - 4180	Lime
4180 - 4486	Lime and Shale
4486 - 4796	Lime
4796 - 4833	Miss.
4833 - 4864	Lime
4864 - 4895	Chert
4895 - 4906	Dolomite
<u>4906</u>	<u>Rotary Total Depth</u>

The undersigned, Robert F. Walters, hereby certifies, in behalf of said company that the above log is a true and correct log of the formations encountered in drilling the above well as reflected by the Daily Drilling Reports.

WALTERS DRILLING CO.


BY

Robert F. Walters

ROBERT F. WALTERS, Partner

Subscribed and sworn to before me


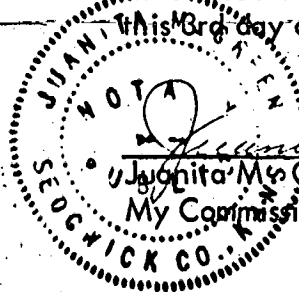

Juanita M. Green
Juanita M. Green, Notary Public
My Commission Expires: October 4, 1967

RECEIVED

OCT - 3 1967

CONSERVATION DIVISION
Wichita, Kansas