

Give All Information Completely
Make Required Affidavit
Mail or Deliver Report to:
Conservation Division
State Corporation Commission
212 No. Market
Wichita, Kansas

WELL PLUGGING RECORD

Ellis County, Sec. 16 Twp. 11S Rge. 18W (E) (W)

Location as "NE/CNW%SW%" or footage from lines SE/4 SE/4 SE/4

Lease Owner Hummon Oil, Incorporated

Lease Name MADDEN (Old well wash down) Well No. 1

Office Address 821 Union National Building, Wichita, Kansas

Character of Well (completed as Oil, Gas or Dry Hole) Dry Hole

Date well completed August 27, 1970 19

Application for plugging filed August 27, 1970 19

Application for plugging approved August 27, 1970 19


Plugging commenced August 27, 1970 19

Plugging completed August 27, 1970 19

Reason for abandonment of well or producing formation
Dry hole

If a producing well is abandoned, date of last production 19

Was permission obtained from the Conservation Division or its agents before plugging was commenced? Yes

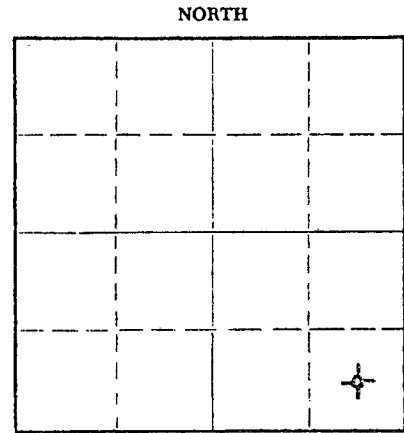

Locate well correctly on above Section Plat

Name of Conservation Agent who supervised plugging of this well Leo F. Massey

Producing formation _____ Depth to top _____ Bottom _____ Total Depth of Well _____ Feet

Show depth and thickness of all water, oil and gas formations.

OIL, GAS OR WATER RECORDS

CASING RECORD

FORMATION	CONTENT	FROM	TO	PUT IN	PULLED OUT
	Filed with original plugging record				
	Sohio Oil Company - #1 Madden				

RECEIVED
STATE CORPORATION COMMISSION
AUG 28 1970
CONSERVATION DIVISION
Wichita, Kansas

Describe in detail the manner in which the well was plugged, indicating where the mud fluid was placed and the method or methods used in introducing it into the hole. If cement or other plugs were used, state the character of same and depth placed, from _____ feet to _____ feet for each plug set.

Filled with heavy mud to 440' -
Plug set at 440' - crushed rock to 420' -
6 yards ready mix cement to bottom of cellar.

(If additional description is necessary, use BACK of this sheet)

Name of Plugging Contractor _____
Address _____

STATE OF KANSAS, COUNTY OF SEDGWICK, ss. C. E. Leith (employee of owner) or (owner or operator) of the above-described

well, being first duly sworn on oath, says: That I have knowledge of the facts, statements, and matters herein contained and the log of the above-described well as filed and that the same are true and correct. So help me God.

(Signature) C. E. Leith - C. E. Leith

821 Union National Building (Address)

Subscribed and sworn to before me this 27th day of August, 1970

July 8, 1974 Barbara K. Budig Notary Public.

