


Give All Information Completely  
Make Required Affidavit  
Mail or Deliver Report to:  
Conservation Division  
State Corporation Commission  
212 No. Market  
Wichita, Kansas

WELL PLUGGING RECORD

NORTH

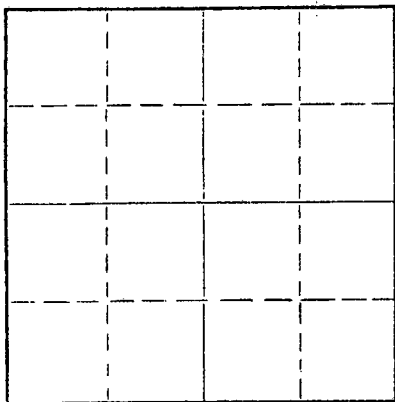

Locate well correctly on above  
Section Plat

Graham County, Sec. 4 Twp. 10 Rge. 25 (E) (W) x  
Location as "NE/CNW/SW" or footage from lines NW NW SE  
Lease Owner Leo J. Dreiling Oil Co.  
Lease Name Pfeifer B Well No. #1  
Office Address Route #2, Victoria, Kansas  
Character of Well (completed as Oil, Gas or Dry Hole) \_\_\_\_\_  
Date well completed \_\_\_\_\_ 19\_\_\_\_  
Application for plugging filed 1-20-69 19\_\_\_\_  
Application for plugging approved \_\_\_\_\_ 19\_\_\_\_  
Plugging commenced 1-23-69 19\_\_\_\_  
Plugging completed 1-28-69 19\_\_\_\_  
Reason for abandonment of well or producing formation \_\_\_\_\_

If a producing well is abandoned, date of last production \_\_\_\_\_ 19\_\_\_\_  
Was permission obtained from the Conservation Division or its agents before plugging was commenced? \_\_\_\_\_

Name of Conservation Agent who supervised plugging of this well W. L. Nichols  
Producing formation \_\_\_\_\_ Depth to top \_\_\_\_\_ Bottom \_\_\_\_\_ Total Depth of Well 4090' Feet  
Show depth and thickness of all water, oil and gas formations.

OIL, GAS OR WATER RECORDS

CASING RECORD

FORMATION	CONTENT	FROM	TO	SIZE	PUT IN	PULLED OUT
				4 1/2"	4087	3360.44'
				8 5/8"	161'	

Describe in detail the manner in which the well was plugged, indicating where the mud fluid was placed and the method or methods used in introducing it into the hole. If cement or other plugs were used, state the character of same and depth placed, from \_\_\_\_\_ feet to \_\_\_\_\_ feet for each plug set.

~~Made bottom hole plug back with sand to 3750', mixed and ran 3 sacks cement thru dump bailer.~~  
~~Squeezed hole with 5 sacks hulls and 10 sacks gel, 100 sacks cement from 1225' - 900'.~~  
~~18 sacks gel from 900' to 180', 20 sacks cement from 180' to 120'. 2 sacks gel from 120' to 40', 10 sacks cement from 40' to 0'.~~

RECEIVED  
STATE CORPORATION COMMISSION  
FEB 5 1969  
CONSERVATION DIVISION  
Wichita, Kansas

(If additional description is necessary, use BACK of this sheet)

Name of Plugging Contractor Southwest Casing Pulling Co.  
Address Box 364, Great Bend, Kansas

STATE OF Kansas, COUNTY OF Barton, ss.  
Southwest Casing Pulling Co. (employee of owner) or (owner or operator) of the above-described well, being first duly sworn on oath, says: That I have knowledge of the facts, statements, and matters herein contained and the log of the above-described well as filed and that the same are true and correct. So help me God.

(Signature) W. C. Spencer Sec.  
Box 364, Great Bend, Kansas  
(Address)

SUBSCRIBED AND SWORN TO before me this 4 day of February, 19 69

My commission expires October 1972  
Notary Public.

L. J. DREILING and SONS, Inc.  
VICTORIA, KANSAS

WELL LOG

Company	Leo J. Dreiling Oil Company	Sec. 4	Twp. 10	Rng. 25
	Route 2			
	Victoria, Kansas 67671			
Farm	Pfeifer B No. 1	Location Approximately NW NW SE		
Total Depth	4090'	County	Graham	
Comm.	7-18-68 Comp. 7-30-68	Elevation:	2542'	K.B.
Contractor	L. J. Dreiling & Sons, Inc.		2539'	D. F.
	Route 2		2537'	G. R.
	Victoria, Kansas 67671			
	Casing Record	Cement Record	Production:	
	161' - 8 5/8"	125 sacks cement		
	4087' - 4 1/2"	125 sacks cement		

RECEIVED  
STATE CORPORATION COMMISSION  
JAN 22 1969  
CONSERVATION DIVISION  
Wichita, Kansas

Figures Indicate Bottom of Formations

0'	60'	Surface Soil & Sand
60'	145'	Sand & Yellow Clay
145'	161'	Blue Shale
161'	1270'	Shale & Shells
1270'	1775'	Shale, Sand & Redbed
1775'	1965'	Sand
1965'	2192'	Shale & Redbed
2192'	2235'	Anhy.
2235'	2650'	Shale & Lime
2650'	2805'	Shale & Lime Shells
2805'	3095'	Lime
3095'	3725'	Lime & Shale
3725'	3820'	Lime (Chalky) & Shale
3820'	3854'	Chalky Lime
3854'	4090'	Lime
4090'	T.D.	

STATE OF KANSAS)  
                                  )ss  
COUNTY OF ELLIS)

I, Leo F. Dreiling, of the L. J. Dreiling & Sons, Inc., upon oath states that the above and foregoing is a true and correct copy from the Daily Drilling Report from your Pfeifer B #1.

GIB SCHECK  
11075 62-5-7400

Leo F. Dreiling  
LEO F. DREILING

Subscribed and sworn to before me this 31st. day of July 1968.

Joseph A. Hess  
JOSEPH A. HESS NOTARY PUBLIC



My Commission Expires: September 19, 1970