

CARD MUST BE TYPED

State of Kansas  
**NOTICE OF INTENTION TO DRILL**

CARD MUST BE SIGNED

(see rules on reverse side)

Starting Date: ..... 3 ..... 13 ..... 85 .....  
month day year

API Number 15- 195-21,687-00-00

**OPERATOR:** License # ..... 5198 .....  
Name ..... A. Scott Ritchie .....  
Address ..... 125 N. Market, Suite 950 .....  
City/State/Zip ..... Wichita, KS ..... 67202 .....  
Contact Person ..... Jeff Christian .....  
Phone ..... (316) 267-4375 .....

SW SW NE ..... Sec 24 Twp 12 S, Rge 22  East  
(location)  West  
2970 ..... Ft North from Southeast Corner of Section  
2310 ..... Ft West from Southeast Corner of Section  
(Note: Locate well on Section Plat on reverse side)

**CONTRACTOR:** License # ..... 6033 .....  
Name ..... Murfin Drilling .....  
City/State ..... Wichita, KS .....

Nearest lease or unit boundary line ..... 330 ..... feet.  
County ..... Trego .....  
Lease Name ..... Steckline ..... Well# ..... 1 .....

**Well Drilled For:**  Oil  Swd  Gas  OWWO  Expl  
**Well Class:**  Infield  Pool Ext.  Wildcat  
**Type Equipment:**  Mud Rotary  Air Rotary  Cable

Domestic well within 330 feet :  yes  no  
Municipal well within one mile :  yes  no

Depth to Bottom of fresh water ..... 100 ..... feet  
Lowest usable water formation ..... Dakota .....  
Depth to Bottom of usable water ..... 1000 ..... feet  
Surface pipe by Alternate : 1  2   
Surface pipe to be set ..... 280 ..... feet  
Conductor pipe if any required ..... feet  
Ground surface elevation ..... Est. 2344 ..... feet MSL  
This Authorization Expires ..... 9-8-85 .....  
Approved By ..... 3-8-85 ..... *[Signature]* .....

If OWWO: old well info as follows:  
Operator .....  
Well Name .....  
Comp Date ..... Old Total Depth .....  
Projected Total Depth ..... 4050 ..... feet  
Projected Formation at TD ..... Arbuckle .....  
Expected Producing Formations ..... Marmaton .....

I certify that we will comply with K.S.A. 55-101, et seq., plus eventually plugging hole to K.C.C. specifications.

Date 3-8-85 Signature of Operator or Agent *Jeff Christian* Title Geologist

MHC/LOHE 3-8-85

**RECEIVED**  
STATE CORPORATION COMMISSION


Must be filed with the K.C.C. five (5) days prior to commencing well  
This card void if drilling not started within six (6) months of date received by K.C.C.

MAR 8 1985

03-08-1985

CONSERVATION DIVISION  
A Regular Section of Land

1 Mile = 5,280 Ft.

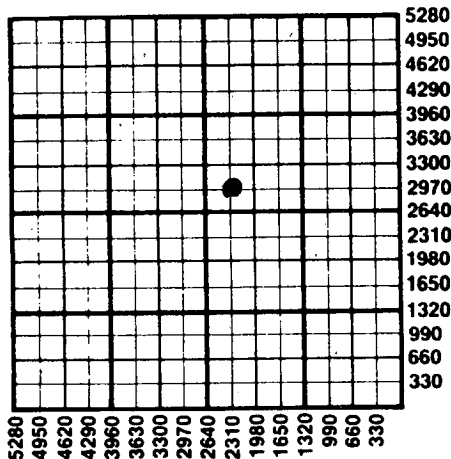

**Important procedures to follow:**

1. Notify District office before setting surface casing.
2. Set surface casing by circulating cement to the top.
3. File completion forms ACO-1 with K.C.C. within 90 days of well completion, following instructions on ACO-1, side 1, and including copies of wireline logs.
4. Notify District office 48 hours prior to old well workover or re-entry.
5. Prior to plugging, prepare a plugging plan, then obtain agreement from the appropriate district office for an approved plugging plan.
6. Submit plugging report (CP-4) to K.C.C. after plugging is completed.
7. Obtain an approved injection docket number before disposing of salt water.
8. Notify K.C.C. within 10 days when injection commences or terminates.
9. If an alternate 2 completion, cement in the production pipe from below any usable water to surface within 120 days of spud date.

**State Corporation Commission of Kansas  
Conservation Division  
200 Colorado Derby Building  
Wichita, Kansas 67202  
(316) 263-3238**