

CARD MUST BE TYPED

State of Kansas
NOTICE OF INTENTION TO DRILL

CARD MUST BE SIGNED

(see rules on reverse side)

Starting Date: 3 13 85
month day year

API Number 15- 195-21,688-00-00

OPERATOR: License # 5198
Name A. Scott Ritchie
Address 125 N. Market St. 950
City/State/Zip Wichita, Ks. 67202
Contact Person Jeff Christian
Phone (316) 267-4375

SW.. SE.. NE. Sec. 24 .. Twp. 12. S, Rge 22 .. East
(location) West

29.70 Ft North from Southeast Corner of Section
9.90 Ft West from Southeast Corner of Section
(Note: Locate well on Section Plat on reverse side)

CONTRACTOR: License # 6033
Name Murfin Drilling
City/State Wichita, Ks.

Nearest lease or unit boundary line .330 feet.
Countyrego.....
Lease Name Steckline Well# ...2.....

Domestic well within 330 feet : yes no
Municipal well within one mile : yes no

Well Drilled For: Well Class: Type Equipment:
 Oil Swd Infield Mud Rotary
 Gas Inj Pool Ext. Air Rotary
 OWWO Expl Wildcat Cable

Depth to Bottom of fresh water ..100 feet
Lowest usable water formation ..Dakota.....
Depth to Bottom of usable water ...100.0 feet
Surface pipe by Alternate : 1 2
Surface pipe to be set280 feet
Conductor pipe if any required feet
Ground surface elevation2234 est..... feet MSL
This Authorization Expires 9-8-85
Approved By 3-8-85 *[Signature]*

If OWWO: old well info as follows:
Operator
Well Name
Comp Date Old Total Depth
Projected Total Depth 4050 feet
Projected Formation at TDArbuckle.....
Expected Producing Formations Marmaton.....

I certify that we will comply with K.S.A. 55-101, et seq., plus eventually plugging hole to K.C.C. specifications.

Date 3-8-85 Signature of Operator or Agent *[Signature]* Title Geologist.....


MITCH/DONE 3-8-85

RECEIVED
 STATE CORPORATION COMMISSION

Must be filed with the K.C.C. five (5) days prior to commencing well
 This card void if drilling not started within six (6) months of date received by K.C.C.

MAR 2 1985
 03-08-1985
 CONSERVATION DIVISION
 WICHITA, KANSAS

A Regular Section of Land
 1 Mile = 5,280 Ft.

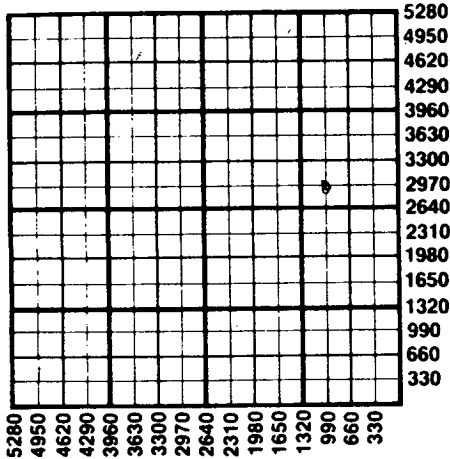

Important procedures to follow:

1. Notify District office before setting surface casing.
2. Set surface casing by circulating cement to the top.
3. File completion forms ACO-1 with K.C.C. within 90 days of well completion, following instructions on ACO-1, side 1, and including copies of wireline logs.
4. Notify District office 48 hours prior to old well workover or re-entry.
5. Prior to plugging, prepare a plugging plan, then obtain agreement from the appropriate district office for an approved plugging plan.
6. Submit plugging report (CP-4) to K.C.C. after plugging is completed.
7. Obtain an approved injection docket number before disposing of salt water.
8. Notify K.C.C. within 10 days when injection commences or terminates.
9. If an alternate 2 completion, cement in the production pipe from below any usable water to surface within 120 days of spud date.

State Corporation Commission of Kansas
 Conservation Division
 200 Colorado Derby Building
 Wichita, Kansas 67202
 (316) 263-3238