


Give All Information Completely  
Make Required Affidavit  
Mail or Deliver Report to:  
Conservation Division  
State Corporation Commission  
211 No. Broadway  
Wichita, Kansas

15-065-02079-0000  
WELL PLUGGING RECORD

NORTH

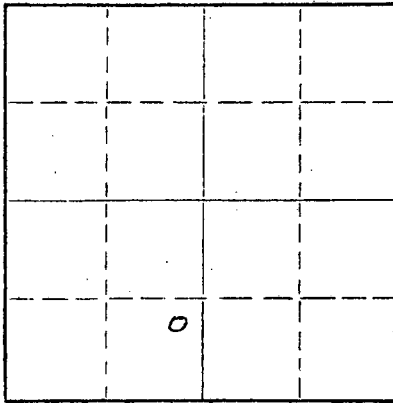

Locate well correctly on above Section Plat

Graham County. Sec. 9 Twp. 10 S Rge. (E) 25 (W)  
Location as "NE/CNW/SW" or footage from lines Kimbar NE SE SW  
Lease Owner Kimbar Exploration Company  
Lease Name Billinger Well No. 1  
Office Address 201 Univ. Blvd. - Denver 6, Colo.  
Character of Well (completed as Oil, Gas or Dry Hole) Dry Hole  
Date well completed 7/17 19 62  
Application for plugging filed 7/25 19 62  
Application for plugging approved \_\_\_\_\_ 19 \_\_\_\_\_  
Plugging commenced 7/18 19 62  
Plugging completed 7/18 19 62  
Reason for abandonment of well or producing formation \_\_\_\_\_

If a producing well is abandoned, date of last production \_\_\_\_\_ 19 \_\_\_\_\_  
Was permission obtained from the Conservation Division or its agents before plugging was commenced? Yes

Name of Conservation Agent who supervised plugging of this well Eldon Pettey  
Producing formation \_\_\_\_\_ Depth to top \_\_\_\_\_ Bottom \_\_\_\_\_ Total Depth of Well 4055 Feet  
Show depth and thickness of all water, oil and gas formations.

OIL, GAS OR WATER RECORDS

CASING RECORD

FORMATION	CONTENT	FROM	TO	SIZE	PUT IN	PULLED OUT
		Surface	204'	8 5/8"	150 sxs	

Describe in detail the manner in which the well was plugged, indicating where the mud fluid was placed and the method or methods used in introducing it into the hole. If cement or other plugs were used, state the character of same and depth placed, from \_\_\_\_\_ feet to \_\_\_\_\_ feet for each plug set.

560-490 - 20 sacks cement  
204-180 - 20 sacks cement  
30-0 - 10 sacks cement

RECEIVED  
STATE CORPORATION COMMISSION

JUL 26 1962

CONSERVATION DIVISION  
Wichita, Kansas

(If additional description is necessary, use BACK of this sheet)  
Name of Plugging Contractor Kimbar Exploration Company  
Address 201 Univ. Blvd. - Denver 6, Colorado

STATE OF Colorado, COUNTY OF Denver, ss.  
W. K. Arbuckle (employee of owner) or (owner or operator) of the above-described well, being first duly sworn on oath, says: That I have knowledge of the facts, statements, and matters herein contained and the log of the above-described well as filed and that the same are true and correct. So help me God.

(Signature) W. K. Arbuckle  
201 University Blvd. - Denver 6, Colo.  
(Address)



SUBSCRIBED AND SWORN TO before me this 25th day of July, 19 62  
Notary Public

15-065-02079-0000

BILLINGER #1 WELL

Location: NE SE SW Section 9  
T-10-S, R-25-W  
Graham County, Kansas

Spudded: 7/9/62  
Completed: 7/18/62

Owner: Kimbark Exploration Company  
201 University Blvd.  
Denver 6, Colorado

Contractor: Kimbark Exploration Co.  
201 University Blvd.  
Denver 6, Colorado

Surface Casing: 8 5/8" ss casing cemented at 204' K.B. with 150 sacks quick set.

Oil String: None

LOG

Figures indicate bottom of formation

185	Sand-Clay
206	Shale
1,570	Shale Sand
2,015	Shale
2,300	Shale
2,550	Shale-Shells
2,690	Lime
2,815	Shale-Lime
2,975	Lime
3,260	Lime
3,530	Lime
3,825	Lime
3,945	Lime
4,055	Lime
4,055	Rotary Total Depth

**RECEIVED**  
STATE CORPORATION COMMISSION  
JUL 26 1962  
CONSERVATION DIVISION  
Wichita, Kansas

The undersigned, W. K. Arbuckle, President of Kimbark Exploration, hereby certifies that the above is a true and correct log of the formations encountered in drilling the Billinger #1 as shown in the daily drilling reports.

KIMBARK EXPLORATION COMPANY

*W. K. Arbuckle*

W. K. Arbuckle, President

STATE OF COLORADO ) ss  
CITY & COUNTY OF DENVER)

Be it remembered that on this 25th day of July A.D. 1962, before me, Marilyn A. Rehm, a Notary Public, personally appeared W. K. Arbuckle, President of Kimbark Exploration Company, a Colorado Corporation, who is personally known to me and known to me to be the President of said Corporation, and the same person who executed the foregoing instrument, and he duly acknowledged the execution of the same for and on behalf of and as the act and deed of said Corporation.

WITNESS my hand and official seal:  
My Commission Expires November 15, 1964

*Marilyn A. Rehm*  
Notary Public