


15-065-02088-0000

STATE OF KANSAS
STATE CORPORATION COMMISSION
Give All Information Completely
Make Required Affidavit
Mail or Deliver Report to:
Conservation Division
State Corporation Commission
211 No. Broadway
Wichita, Kansas

WELL PLUGGING RECORD

Braham County, Sec. 9 Twp. 10S Rge. 25 (E) 25 (W)

Location as "NE/CNW&SW" or footage from lines NW NE SW
Lease Owner Cooperative Refinery Association
Lease Name BILLINGER Well No. 2
Office Address Great Bend, Kansas
Character of Well (completed as Oil, Gas or Dry Hole) Dry
Date well completed 5/27 19 59
Application for plugging filed 5/27 19 59
Application for plugging approved 5/27 19 59
Plugging commenced 5/27 19 59
Plugging completed 5/27 19 59
Reason for abandonment of well or producing formation Dry

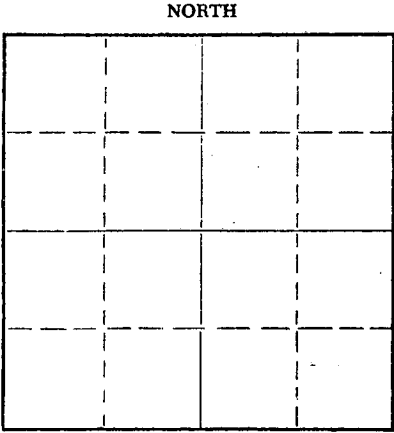

Locate well correctly on above Section Plat

If a producing well is abandoned, date of last production _____ 19 ____
Was permission obtained from the Conservation Division or its agents before plugging was commenced? yes

Name of Conservation Agent who supervised plugging of this well Fabricius, Hill City, Kansas
Producing formation _____ Depth to top _____ Bottom _____ Total Depth of Well 4290 Feet
Show depth and thickness of all water, oil and gas formations.

OIL, GAS OR WATER RECORDS

CASING RECORD

FORMATION	CONTENT	FROM	TO	SIZE	PUT IN	PULLED OUT
				8-5/8"	250'	None

Describe in detail the manner in which the well was plugged, indicating where the mud fluid was placed and the method or methods used in introducing it into the hole. If cement or other plugs were used, state the character of same and depth placed, from _____ feet to _____ feet for each plug set.

First plug set at 600 feet with 20 sacks cement
Second plug set at 250 feet with 20 sacks cement
Third plug set at 40 feet with 10 sacks cement and 1/2 sack hulls

(If additional description is necessary, use BACK of this sheet)
Name of Plugging Contractor JOHN O. FARMER, INC.
Address Russell, Kansas

STATE OF Kansas, COUNTY OF Russell, ss.
I, JOHN O. FARMER (employee of owner) or (owner or operator) of the above-described well, being first duly sworn on oath, says: That I have knowledge of the facts, statements, and matters herein contained and the log of the above-described well as filed and that the same are true and correct. So help me God.

(Signature) John O. Farmer
Russell, Kansas
(Address)



6-2-59

Lucille Kennedy
Notary Public.


PLUGGING
FILE SEC 9 T 10 R2 SW
BOOK PAGE 42 LINE 39

ADDRESS Great Bend, Kansas

Give detailed description and thickness of all formation drilled through, contents of sand, whether dry, water, oil or gas.

640 Acres

N

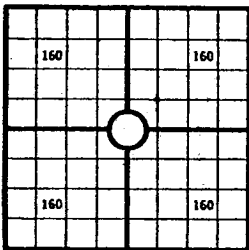

Locate well correctly

COUNTY Graham, SEC. 9, TWP. 10S, RGE. 25W

~~COMPANY OPERATOR~~ CONTRACTOR: John O. Farmer, Inc.

OFFICE ADDRESS Russell, Kansas

DRILLING STARTED 5/16/59, DRILLING FINISHED 5/27, 19.59

DATE OF FIRST PRODUCTION _____ COMPLETED _____

WELL LOCATED NW 1/4 NE 1/4 SW 1/4, North of South

Line and _____ ft. East of West Line of Quarter Section

Elevation (Relative to sea level) DERRICK FLOOR 2544 GROUND, 2541

CHARACTER OF WELL (Oil, gas or dryhole) Dry

OIL OR GAS SANDS OR ZONES

Name	From	To	Name	From	To
1			4		
2			5		
3			6		

Perforating Record If Any

Shot Record

Formation	From	To	No. of Shots	Formation	From	To	Size of Shot

CASING RECORD

Amount Set						Amount Pulled		Packer Record			
Size	Wt.	Thds.	Make	Ft.	In.	Ft.	In.	Size	Length	Depth Set	Make
8-5/8				250							

Liner Record: Amount _____ Kind _____ Top _____ Bottom _____

CEMENTING AND MUDDING

Size	Amount Set		Sacks Cement	Chemical		Method of Cementing	Amount	Mudding Method	Results (See Note)
	Ft.	In.		Gal.	Make				
8-5/8	250		175						

Note: What method was used to protect sands if outer strings were pulled? _____

NOTE: Were bottom hole plugs used? _____ If so, state kind, depth set and results obtained _____

TOOLS USED

Rotary Tools were used from _____ feet to _____ Cable tools were used from _____ feet to _____ feet, and from _____ feet to _____ feet, and from _____ feet to _____ feet to _____

Type Rig _____

INITIAL PRODUCTION TEST

Describe initial test: whether by flow through tubing or casing or by pumping _____

Amount of Oil Production _____ bbls. Size of choke, if any _____ Length of test _____ Water

Production _____ bbls. Gravity of oil _____ Type of Pump if pump is used, describe _____

Formation	Top	Bottom	Formation	Top	Bottom
FARM NAME:			BILLINGER #2		
Shale	0	2250			
Shale & sand	250	1500			
Shale & shells	1500	1745			
Sand	1745	1875			
Shale & shells	1875	2168			
Anhydrite	2168	2213			
Shale & shells	2213	2530			
Shale & lime	2530	2710			
Shale & lime streaks	2710	2890			
Lime & shale	2890	3945			
Lime	3945	3970			
Lime & shale	3970	4085			
Shale & lime	4085	4290			
T.D.		4290			
			ELEVATION: KB		2546
			SAMPLE TOPS:		
			Anhydrite		2168
			Heebner		3786
			Toronto		3810
			Lansing		3830
			B/KC		4059
			Cherokee		4270
			T.D.		4290
			D & A		

PLUGGING
 FILE SEC 9 TWP 10S RGE 25W
 BOOK PAGE 42 LINE 39

I, the undersigned, being first duly sworn upon oath, state that this well record is true, correct and complete according to the records of this office and to the best of my knowledge and belief.

John O. Farmer
 Name and title of representative of company

Subscribed and sworn to before me this 2nd day of June, 1959

My Commission expires 10/11/62

Lucien Ramsey
 Notary Public.

15-005-02088-0000
 SEC. 9 TWP. 10S RGE. 25W
 COUNTY Graham
 WELL NO. 2
 FARM NAME BILLINGER