

15-005-02062-0000


STATE OF KANSAS
STATE CORPORATION COMMISSION

Give All Information Completely
Make Required Affidavit
Mail or Deliver Report to:
Conservation Division
State Corporation Commission
211 No. Broadway
Wichita, Kansas

WELL PLUGGING RECORD

Graham County, Sec. 9 Twp. 10 Rge. 25 (E) (W) X

NORTH

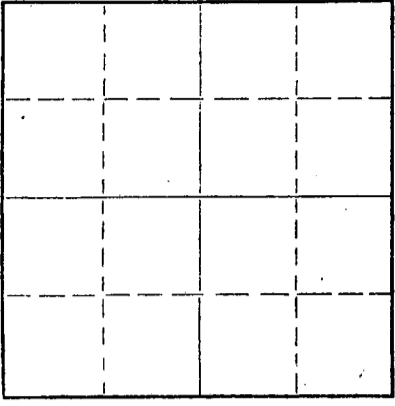

Locate well correctly on above
Section Plat

Location as "NE/CNW/SW" or footage from lines NW NE NE
Lease Owner Empire Drilling Company
Lease Name Riedel B Well No. 5
Office Address 650 Fourth National Bank Building, Wichita, Kansas
Character of Well (completed as Oil, Gas or Dry Hole) Dry hole
Date well completed June 5, 1960 19
Application for plugging filed June 5, 1960 19
Application for plugging approved June 5, 1960 19
Plugging commenced June 5, 1960 19
Plugging completed June 5, 1960 19
Reason for abandonment of well or producing formation Dry hole

If a producing well is abandoned, date of last production _____ 19____
Was permission obtained from the Conservation Division or its agents before plugging was commenced? yes

Name of Conservation Agent who supervised plugging of this well A. D. Fabricius
Producing formation _____ Depth to top _____ Bottom _____ Total Depth of Well 4070 Feet
Show depth and thickness of all water, oil and gas formations.

OIL, GAS OR WATER RECORDS

CASING RECORD

FORMATION	CONTENT	FROM	TO	SIZE	PUT IN	PULLED OUT
	Surface	-0-	163	8 5/8"	135'	

Describe in detail the manner in which the well was plugged, indicating where the mud fluid was placed and the method or methods used in introducing it into the hole. If cement or other plugs were used, state the character of same and depth placed, from _____ feet to _____ feet for each plug set.

Plug set at 500' with 20 sacks cement
Plug set at 135' with 20 sacks cement
Plug set at 40' with 10 sacks cement

RECEIVED
STATE CORPORATION COMMISSION
JUN 21 1960
CONSERVATION DIVISION
Wichita, Kansas

(If additional description is necessary, use BACK of this sheet)
Name of Plugging Contractor Empire Drilling Company
Address 650 Fourth National Bank Building, Wichita, Kansas

STATE OF KANSAS, COUNTY OF SEDGWICK, ss.
Irwin Kornfeld (employee of owner) or (owner or operator) of the above-described well, being first duly sworn on oath, says: That I have knowledge of the facts, statements, and matters herein contained and the log of the above-described well as filed and that the same are true and correct. So help me God.

(Signature) Irwin Kornfeld
650-4th Nat'l. Bank Bldg., Wichita, Kansas
(Address)

Subscribed and Sworn to before me this 17th day of June, 19 60
Lucille H. Harr
Notary Public.



October 21, 1962

LOG

COMPANY: Empire Drilling Company
 CONTRACTOR: Empire Drilling Company
 FAULT: Riedel B # 5
 LOCATION: NW NE NE of Section 9-10S-25W, Graham County, Kansas
 COMMENCED: May 29, 1960 ELEVATION: 2541 KB
 COMPLETED: June 5, 1960 POTENTIAL: D & A

0	to	163	Surface
163	to	800	Shale
800	to	1736	Shale-Shells
1736	to	1960	Sand
1960	to	2189	Shale
2189	to	2223	Anhydrite
2223	to	2855	Shale-Shells
2855	to	2985	Shale-Lime
2985	to	3135	Shale-Shells
3135	to	3830	Shale-Lime
3830	to	3980	Lime
3980	to	4070	Lime-Shale
4070			Rotary Total Depth

SET: 135' 8 5/8" casing with 100 sacks cement

SAMPLE TOPS:

Anhydrite	2189	+ 352
Heebner	3792	-1251
Toronto	3813	-1272
Lansing	3827	=1286
Base Kansas City	4063	-1522

RECEIVED
 STATE CONSERVATION COMMISSION
 JUN 21 1960
 CONSERVATION DIVISION
 Wichita, Kansas

CERTIFICATION

I, Irwin Kornfeld, do hereby certify that the above and foregoing is a true and correct copy of the log on the Riedel B # 5, NW NE NE of Section 9-10S-25W, Graham County, Kansas, as reflected by the files of Empire Drilling Company.


 IRWIN KORNFELD

SUBSCRIBED and sworn to before me, a Notary Public within and for Sedgwick County, Kansas, this 17th day of June, 1960.


 Lucille H. Harr

My commission expires October 21, 1962.