


Give All Information Completely
Make Required Affidavit
Mail or Deliver Report to:
Conservation Division
State Corporation Commission
800 Bitting Building
Wichita, Kansas

15-195-01445-00-00

WELL PLUGGING RECORD

NORTH

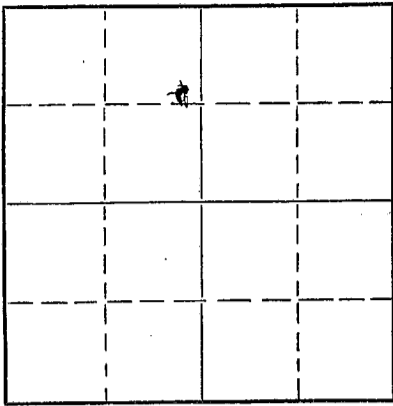

Locate well correctly on above
Section Plat

Trego County, Sec. 25 Twp. 12 Rge. 22 (E) (W)
Location as "NE/CNW/SW" or footage from lines SW NE SW
Lease Owner J. O. Forbes
Lease Name Viola Powers Well No. 1
Office Address P. O. Box 221 Great Bend, Kansas
Character of Well (completed as Oil, Gas or Dry Hole) Dry hole
Date well completed _____ 19____
Application for plugging filed June 15 1953
Application for plugging approved June 17 1953
Plugging commenced June 20 1953
Plugging completed June 29 1953
Reason for abandonment of well or producing formation Dry Hole

If a producing well is abandoned, date of last production No 19____
Was permission obtained from the Conservation Division or its agents before plugging was commenced? Yes

Name of Conservation Agent who supervised plugging of this well Eldon Petty
Producing formation _____ Depth to top _____ Bottom _____ Total Depth of Well 4047' Feet
Show depth and thickness of all water, oil and gas formations.

OIL, GAS OR WATER RECORDS

CASING RECORD

FORMATION	CONTENT	FROM	TO	SIZE	PUT IN	PULLED OUT

Describe in detail the manner in which the well was plugged, indicating where the mud fluid was placed and the method or methods used in introducing it into the hole. If cement or other plugs were used, state the character of same and depth placed, from _____ feet to _____ feet for each plug set.

Work started June 20, 1953.

Hole was filled back from T.D. 4047' with crushed rock to 4000'
Dumped 6 sacks cement with bailer. Shot casing off at 3000' - pulled pipe out of hole - filled hole with heavy mud to 360' and set permanent rock bridge in surface casing. Dumped 15 sacks cement. Filled hole with mud to 30' of top - dumped 10 sacks cement for cap on well.

Work completed June 29, 1953.

(If additional description is necessary, use BACK of this sheet)
Name of Plugging Contractor Forbes Casing Pulling Company
Address P. O. Box 221 Great Bend, Kansas

STATE OF Kansas COUNTY OF Barton, ss.
J. O. Forbes (owner or operator) of the above-described well, being first duly sworn on oath, says: That I have knowledge of the facts, statements, and matters herein contained and the log of the above-described well as filed and that the same are true and correct. So help me God.

(Signature) J. O. Forbes
221 Great Bend, (Address)

SUBSCRIBED AND SWORN TO before me this 28th day of September 1953
John W. Foss Notary Public.

My commission expires April 11, 1955

