


Give All Information Completely  
Make Required Affidavit  
Mail or Deliver Report to:  
Conservation Division  
State Corporation Commission  
212 North Market, Insurance Bldg.  
Wichita, Kansas

WELL PLUGGING RECORD

Graham County. Sec. 26 Twp. 10S Rge. (E) 21 (W)

Location as "NE/CNW&SW&" or footage from lines SE SE NW  
Lease Owner Rocket-Schusterman Oil Account  
Lease Name Holzauer Well No. 1  
Office Address 2700 First National Tower, Tulsa, OK 74103  
Character of Well (completed as Oil, Gas or Dry Hole) Oil  
Date well completed August 10 19 56  
Application for plugging filed December 1 19 78  
Application for plugging approved December 6 19 78  
Plugging commenced December 27 19 78  
Plugging completed December 27 19 78  
Reason for abandonment of well or producing formation Depleted

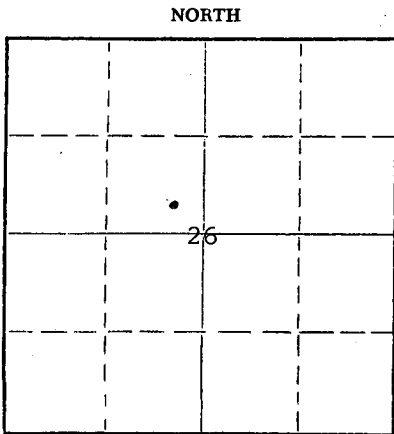

Locate well correctly on above Section Plat

If a producing well is abandoned, date of last production 19  
Was permission obtained from the Conservation Division or its agents before plugging was commenced? Yes

Name of Conservation Agent who supervised plugging of this well Gilbert Balthazor  
Producing formation Lansing Depth to top 3516 Bottom 3520 Total Depth of Well 3550 Feet  
Show depth and thickness of all water, oil and gas formations.


OIL, GAS OR WATER RECORDS

CASING RECORD

FORMATION	CONTENT	FROM	TO	SIZE	PUT IN	PULLED OUT
Lansing	Oil	3516	3520	8-5/8	218	None
Arbuckle	Dry			5 1/2	3757	None

Describe in detail the manner in which the well was plugged, indicating where the mud fluid was placed and the method or methods used in introducing it into the hole. If cement or other plugs were used, state the character of same and depth placed, from \_\_\_\_\_ feet to \_\_\_\_\_ feet for each plug set.

Set wooden plug on top of fluid level at 976 feet and plugged back with rocks and dirt to 926 feet. Plugged back to surface with five cubic yards (approximately 110 sacks) of Ready Mix concrete. Well plugged and abandoned at 2:30 p.m.

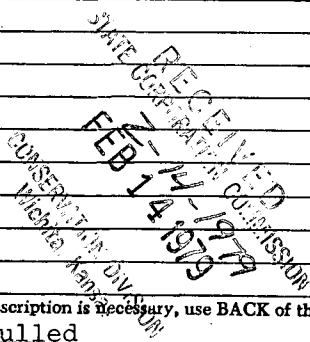

(If additional description is necessary, use BACK of this sheet)

Name of Plugging Contractor None--No pipe pulled  
Address \_\_\_\_\_

STATE OF OKLAHOMA, COUNTY OF TULSA, ss.  
R. J. DAVIS

(employee of owner) or (owner or operator) of the above-described well, being first duly sworn on oath, says: That I have knowledge of the facts, statements, and matters herein contained and the log of the above-described well as filed and that the same are true and correct. So help me God.

(Signature) R. J. Davis  
2700 First National Tower, Tulsa, OK 74103  
(Address)

SUBSCRIBED AND SWORN TO before me this 8th day of January, 19 79

My commission expires June 16, 1982

Notary Public.



DRILLERS' LOG

Company: Anderson-Frithard Oil Corporation

SE SE NW

Farm Name: Holzhauser Well No. 1

Sec. 26, Twp. 10S, Rge. 21W,

Total Depth: 3759'

County: Graham,  
Kansas

Comm: 7/7/56 Comp: 7/16/56

Elevation:

Contractor: Glenn W. Peel

Production:

Casing: 8 5/8" @ 218' cem.  
5 1/2" @ 3753' cem.

Figures below indicate bottoms of formations:

Surface clay	0 -	25
Shale and shells		219
Shale		1120
Sand		1300
Shale		1635
Anhydrite		1680
Shale and lime		3325
Lime		3645
Lime and shale		3710
Lime and conglomerate		3759
Total Depth		3759

This is to certify that the above information is to the best of our knowledge, true and correct.

GLENN W. PEEL

BY: Al H. Smith

SUBSCRIBED AND SWORN to before me this 16th day of July, 1956.

My commission expires: April 27, 1960

Robert Smith  
Notary Public

RECEIVED  
STATE COMMISSION  
12-5-1978  
DEC - 5 1978

CONSERVATION DIVISION  
LAWRENCE, KANSAS