

15-065-02642-00-00

STATE OF KANSAS  
STATE CORPORATION COMMISSION

Give All Information Completely  
Make Required Affidavit  
Mail or Deliver Report to:  
Conservation Division  
State Corporation Commission  
211 No. Broadway  
Wichita, Kansas

WELL PLUGGING RECORD

Graham County, Sec. 1 Twp. 10S Rge. (E) 22 (W)

Location as "NE/CNW/SW" or footage from lines SE NW NW

Lease Owner John O. Farmer, Inc.

Lease Name GUSTAFSON "C" Well No. 2

Office Address Russell, Kansas

Character of Well (completed as Oil, Gas or Dry Hole) Dry

Date well completed 11/29 1958

Application for plugging filed 11/29 1958

Application for plugging approved 11/29 1958


Plugging commenced 11/29 1958

Plugging completed 11/29 1958

Reason for abandonment of well or producing formation Dry

If a producing well is abandoned, date of last production 19

Was permission obtained from the Conservation Division or its agents before plugging was commenced? yes

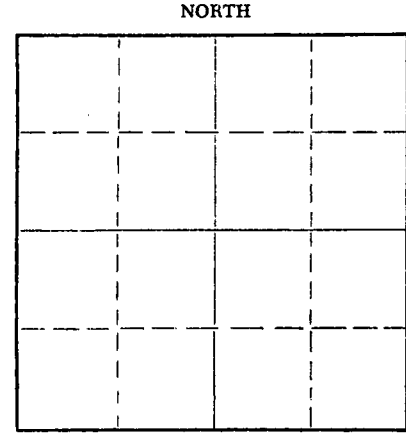

Locate well correctly on above Section Plat

Name of Conservation Agent who supervised plugging of this well A. D. Fabricius, Hill City, Kansas

Producing formation Depth to top Bottom Total Depth of Well 3780 Feet

Show depth and thickness of all water, oil and gas formations.

OIL, GAS OR WATER RECORDS

CASING RECORD

FORMATION	CONTENT	FROM	TO	SIZE	PUT IN	PULLED OUT
				8-5/8"	160'	None

Describe in detail the manner in which the well was plugged, indicating where the mud fluid was placed and the method or methods used in introducing it into the hole. If cement or other plugs were used, state the character of same and depth placed, from feet to feet for each plug set.

First plug set at 600 feet with 20 sacks cement

Second plug set at 160 feet with 20 sacks cement

Third plug set at 40 feet with 10 sacks cement

(If additional description is necessary, use BACK of this sheet)

Name of Plugging Contractor JOHN O. FARMER, INC.

Address Russell, Kansas

STATE OF Kansas, COUNTY OF Russell, ss.

JOHN O. FARMER (owner or operator) of the above-described

well, being first duly sworn on oath, says: That I have knowledge of the facts, statements, and matters herein contained and the log of the above-described well as filed and that the same are true and correct. So help me God.

(Signature) John O. Farmer

Russell, Kansas (Address)

SUBSCRIBED AND SWORN TO before me this 2nd day of December, 1958

My commission expires October 11, 1962

Lucille Kennedy

VED  
COMMISSION  
12-5-1958  
DEC 5 1958  
Notary Public  
CONSERVATION DIVISION  
Wichita, Kansas


PLUGGING  
FILE SEC. 1 T. 10 R. 22W  
BOOK PAGE 1 LINE 34

OPERATOR JOHN O. FARMER, INC.ADDRESS Russell, Kansas

15-065-02642-00-00

FORMATION RECORD

Give detailed description and thickness of all formations drilled through, contents of sand, whether dry, water, oil or gas.

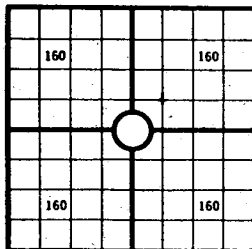640 Acres  
N

Locate well correctly

COUNTY Graham SEC 1 TWP 10S RGE 22W  
 COMPANY OPERATING John O. Farmer, Inc.  
 OFFICE ADDRESS Russell, Kansas  
 FARM NAME GUSTAFSON "C" WELL NO. 2  
 DRILLING STARTED 11/19/58 DRILLING FINISHED 11/29/58  
 DATE OF FIRST PRODUCTION \_\_\_\_\_ COMPLETED \_\_\_\_\_  
 WELL LOCATED SE 1/4 NW 1/4 NW 1/4 North of South  
 Line and \_\_\_\_\_ ft. East of West Line of Quarter Section  
 Elevation (Relative to sea level) DERRICK FLOOR 2310 GROUND 2308  
 CHARACTER OF WELL (Oil, gas or dryhole) Dry

## OIL OR GAS SANDS OR ZONES

Name	From	To	Name	From	To
1			4		
2			5		
3			6		

## Perforating Record If Any

## Shot Record

Formation	From	To	No. of Shots	Formation	From	To	Size of Shot

## CASING RECORD

Amount Set								Amount Pulled		Packer Record	
Size	Wt.	Thds.	Make	Ft.	In.	Ft.	In.	Size	Length	Depth Set	Make
8-5/8				160							

Liner Record: Amount \_\_\_\_\_ Kind \_\_\_\_\_ Top \_\_\_\_\_ Bottom \_\_\_\_\_

## CEMENTING AND MUDDING

Size	Amount Set		Sacks Cement	Chemical		Method of Cementing	Amount	Mudding Method	Results (See Note)
	Ft.	In.		Gal.	Make				
8-5/8	160		115						

Note: What method was used to protect sands if outer strings were pulled? \_\_\_\_\_

NOTE: Were bottom hole plugs used? \_\_\_\_\_ If so, state kind, depth set and results obtained \_\_\_\_\_

## TOOLS USED

Rotary Tools were used from \_\_\_\_\_ feet to \_\_\_\_\_ Cable tools were used from \_\_\_\_\_ feet to \_\_\_\_\_

\_\_\_\_\_ feet, and from \_\_\_\_\_ feet to \_\_\_\_\_ feet, and from \_\_\_\_\_ feet to \_\_\_\_\_

Type Rig \_\_\_\_\_

## INITIAL PRODUCTION TEST

Describe initial test: whether by flow through tubing or casing or by pumping \_\_\_\_\_

Amount of Oil Production \_\_\_\_\_ bbls. Size of choke, if any \_\_\_\_\_ Length of test \_\_\_\_\_ Water

Production \_\_\_\_\_ bbls. Gravity of oil \_\_\_\_\_ Type of Pump if pump is used, describe \_\_\_\_\_

I, the undersigned, being first duly sworn upon oath, state that this well record is true, correct and complete according to the records of this office and to the best of my knowledge and belief.

*John O. Farmer*  
 President  
 Name and title of representative of company

Subscribed and sworn to before me this 2nd day of December 19 58My Commission expires 10/11/62 *Luille Kennedy*  
Notary Public.

FILE SEC 1 T 10 R 22W  
 BOOK PAGE 1 LINE 34  
 PLUGGING

Formation	Top	Bottom	Formation	Top	Bottom
Sand & shale	0	160			
Shale	160	560			
Shale & sand	560	1785			
Anhydrite	1785	1820			
Shale & shells	1820	2340			
Lime & shale	2340	3555			
Lime	3555	3755			
Lime & shale	3755	3780			
T.D.		3780			

TOPS:  
 ELEVATION: RB 2312  
 Anhydrite 1785  
 Heebner 3506  
 Toronto 3528  
 Lansing 3543  
 B/Kansas City 3777  
 Total Depth 3780

D & A

15-065-02642-00-00  
 GUSTAFSON "C"  
 WELL NO. 2  
 COUNTY Graham  
 SEC. 1  
 TWP. 10S  
 RGE. 22W