

WELL PLUGGING RECORD

Give All Information Completely
Make Required Affidavit
Mail or Deliver Report to
Conservation Division
State Corporation Comm.
245 North Water
Wichita, KS 67202

Graham County Sec. 1 Twp. 10s Rge. 22 ~~NE~~W
Location as "NE/CNW/SW" or footage from lines _____
NW NE SW/4

Lease Owner F & J Oil Company, Inc.
Lease Name Noah Well No. 2
Office Address Box 735 El Dorado, KS 67042

Character of Well (Completed as Oil, Gas or Dry Hole) _____
Dry Hole


Date Well completed April 22 1981
Application for plugging filed April 22 1981
Application for plugging approved April 22 1981
Plugging commenced 9:00 P.M. April 22 1981
Plugging completed 10:15 P.M. April 22 1981

Reason for abandonment of well or producing formation _____
no Commercial production

If a producing well is abandoned, date of last production _____
19 _____

Was permission obtained from the Conservation Division or its agents before plugging was commenced? yes

Name of Conservation Agent who supervised plugging of this well Gil Balthazor
Producing formation _____ Depth to top _____ Bottom _____ Tl. Depth of Well _____
Show depth and thickness of all water, oil and gas formations.

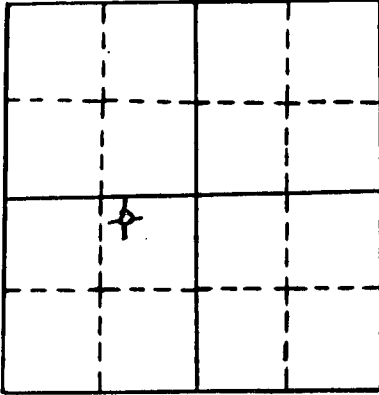

locate well correctly
on above
Section Plot


OIL, GAS OR WATER RECORDS

CASING RECORD

FORMATION	CONTENT	FROM	TO	SIZE	PUT IN	PULLED OUT
surface Casing	common	0'	208.29'	8 5/8"	208.29'	0'

Describe in detail the manner in which the well was plugged, indicating where the mud fluid was placed and the method or methods used in introducing it into the hold. If cement or other plugs were used, state the character of same and depth placed, from _____ feet to _____ feet for each plug set.

- Plug #1 @ 800' with 60 sxs
- Plug #2 @ 220' with 30 sxs
- Plug #3 @ 40' with 10 sxs
- 5 sxs in rathole
- Total 105 sxs 50/50 poz 6% gel

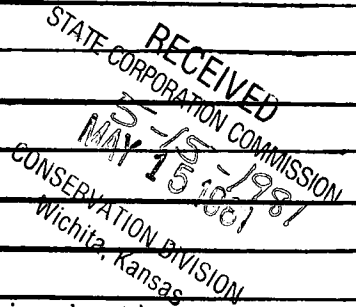


(If additional description is necessary, use BACK of this sheet)

Name of Plugging Contractor Pioneer Drilling Company, Inc.
308 West Mill Plainville, KS 67663

STATE OF Kansas COUNTY OF Graham, ss.

Kent Noah (employee of owner) or (owner or operator) of the above described well, being first duly sworn on oath, says: That I have knowledge of the facts, statements and matters herein contained and the log of the above described well is filed and that the same are true and correct. So help me God.

(Signature) Kent Noah
(Address) Box 'D' - Hill City, Ks.

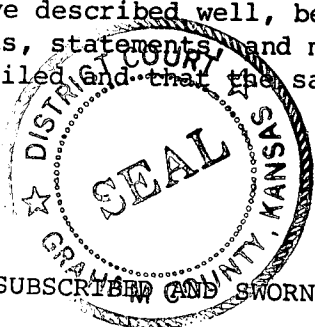

SUBSCRIBER AND SWORN TO before me this 14th day of May, 1981

My commission expires Term of office

Genevieve Brunk
Notary Public Clerk of Dist. Court