

WELL PLUGGING RECORD

Give All Information Completely
Make Required Affidavit
Mail or Deliver Report to:
Conservation Division
State Corporation Commission
211 No. Broadway
Wichita, Kansas

Graham County. Sec. 1 Twp. 10S Rge. (E) 22 (W)

Location as "NE/CNW%SW%" or footage from lines. C N/2 NW/4 SW/4

Lease Owner John O. Farmer, Inc.

Lease Name NOAH "E" Well No. 1

Office Address Russell, Kansas

Character of Well (completed as Oil, Gas or Dry Hole) Dry

Date well completed 8/14 1958

Application for plugging filed 8/14 1958

Application for plugging approved 8/14 1958

Plugging commenced 8/14 1958

Plugging completed 8/14 1958

Reason for abandonment of well or producing formation Dry

If a producing well is abandoned, date of last production _____ 19____

Was permission obtained from the Conservation Division or its agents before plugging was commenced? yes

Name of Conservation Agent who supervised plugging of this well A. D. Fabricius, Hill City, Kansas

Producing formation _____ Depth to top _____ Bottom _____ Total Depth of Well 3750 Feet

Show depth and thickness of all water, oil and gas formations.

OIL, GAS OR WATER RECORDS

CASING RECORD

FORMATION	CONTENT	FROM	TO	SIZE	PUT IN	PULLED OUT
				8-5/8"	160'	None

Describe in detail the manner in which the well was plugged, indicating where the mud fluid was placed and the method or methods used in introducing it into the hole. If cement or other plugs were used, state the character of same and depth placed, from _____ feet to _____ feet for each plug set.

First plug set at 550 feet with 25 sacks cement

Second plug set at 160 feet with 15 sacks cement

Third plug set at 40 feet with 10 sacks cement.

(If additional description is necessary, use BACK of this sheet)

Name of Plugging Contractor John O. Farmer, Inc.

Address Russell, Kansas


STATE OF Kansas, COUNTY OF Russell, ss.

JOHN O. FARMER (employee of contractor) or (owner or operator) of the above-described well, being first duly sworn on oath, says: That I have knowledge of the facts, statements, and matters herein contained and the log of the above-described well as filed and that the same are true and correct. So help me God.

(Signature) John O. Farmer
Russell, Kansas
(Address)

SUBSCRIBED AND SWORN TO before me this 19th day of August, 1958

My commission expires October 11, 1958
Lucille Kennedy
Notary Public.

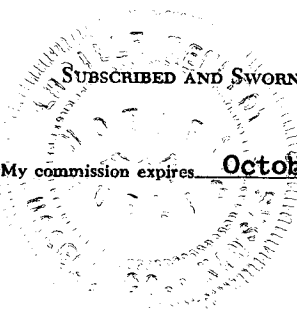


AUG 21 1958
8-21-1958
CONSERVATION DIVISION
Wichita, Kansas

PLUGGING
FILE SEC 1 T. 10 R. 22W
BOOK PAGE 125 LINE 3

OPERATOR JOHN O. FARMER, INC.ADDRESS Russell, Kansas15-065-00555-00-00
FORMATION RECORD

Give detailed description and thickness of all formations drilled through, contents of sand, whether dry, water, oil or gas.

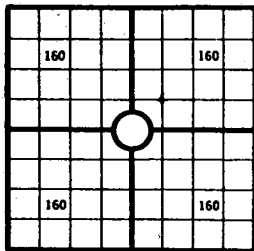640 Acres
N

Locate well correctly

COUNTY Graham, SEC. 1, TWP. 10S, RGE. 22W
 COMPANY OPERATING John O. Farmer, Inc.
 OFFICE ADDRESS Russell, Kansas
 FARM NAME NOAH "E" WELL NO. 1
 DRILLING STARTED 8/4, 1958 DRILLING FINISHED 8/14, 1958
 DATE OF FIRST PRODUCTION _____ COMPLETED _____
 WELL LOCATED N/2 1/4 NW 1/4 SW 1/4, North of South
 Line and _____ ft. East of West Line of Quarter Section
 Elevation (Relative to sea level) DERRICK FLOOR 2284 GROUND 2281
 CHARACTER OF WELL (Oil, gas or dryhole) Dry

OIL OR GAS SANDS OR ZONES

Name	From	To	Name	From	To
1			4		
2			5		
3			6		

Perforating Record If Any

Shot Record

Formation	From	To	No. of Shots	Formation	From	To	Size of Shot

CASING RECORD

Amount Set								Amount Pulled		Packer Record	
Size	Wt.	Thds.	Make	Ft.	In.	Ft.	In.	Size	Length	Depth Set	Make
8 5/8				160							

Liner Record: Amount _____ Kind _____ Top _____ Bottom _____

CEMENTING AND MUDDING

Size	Amount Set		Sacks Cement	Chemical		Method of Cementing	Amount	Mudding Method	Results (See Note)
	Ft.	In.		Gal.	Make				
8 5/8	160		125						

Note: What method was used to protect sands if outer strings were pulled? _____

NOTE: Were bottom hole plugs used? _____ If so, state kind, depth set and results obtained _____

TOOLS USED

Rotary Tools were used from _____ feet to _____ feet. Cable tools were used from _____ feet to _____ feet, and from _____ feet to _____ feet, and from _____ feet to _____ feet.

Type Rig _____

INITIAL PRODUCTION TEST

Describe initial test: whether by flow through tubing or casing or by pumping _____

Amount of Oil Production _____ bbls. Size of choke, if any _____ Length of test _____ Water

Production _____ bbls. Gravity of oil _____ Type of Pump if pump is used, describe _____

Formation	Top	Bottom	Formation	Top	Bottom
Shale & sand	0	880			
Sand	880	990			
Shale, shells & sand	990	1285			
Shale, shells & redbed	1285	1625			
Shale (bedbed)	1625	1768			
Anhydrite	1768	1810			
Shale & shells	1810	1995			
Shale & lime	1995	3430			
Lime & shale	3430	3750			
T.D.		3750			

ELEVATION:

Heebner
 Toronto
 Lansing
 B/KC
 T.D.

RB

2286
 3474
 3496
 3510
 3744
 3750

PLUGGING
 FILE SEC. 1, T. 10, R. 22W
 BOOK PAGE 125 LINE 3

8-21-1958
 AUG 21 1958

I, the undersigned, being first duly sworn upon oath, state that this well record is true, correct and complete according to the records of this office and to the best of my knowledge and belief.

John O. Farmer, Inc.
 Name and title of representative of company

Subscribed and sworn to before me this 10th day of August, 1958.
 My Commission expires 10/11/58

Notary Public.

15-065-00555-00-00
 SEC. 1, TWP. 10S, RGE. 22W
 COUNTY, Graham
 WELL NO. 1
 FARM NAME
 NOAH "E"