


STATE OF KANSAS
STATE CORPORATION COMMISSION

WELL PLUGGING RECORD

Give All Information Completely
Make Required Affidavit
Mail or Deliver Report to
Conservation Division
State Corporation Comm.
245 North Water
Wichita, KS 67202

Graham County, Sec. 1 Twp. 10s Rge. 22W E/W
Location as "NE/CNW $\frac{1}{2}$ /SW $\frac{1}{2}$ " or footage from lines _____
SE NE NW

Lease Owner K & B. Drilling
Lease Name Gustafson Well No. 1
Office Address Box 263 Medicine Lodge Kan. 67104
Character of Well (Completed as Oil, Gas or Dry Hole) _____

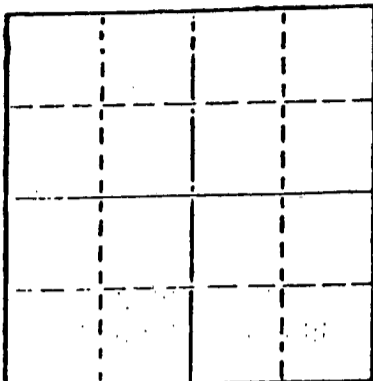

Locate well correctly on above
Section Plot

Dry hole
Date Well completed Jan. 1977
Application for plugging filed 2/28 1977
Application for plugging approved 3/2 1977
Plugging commenced 3/7 1977
Plugging completed 3/10 1977
Reason for abandonment of well or producing formation _____

DRY
If a producing well is abandoned, date of last production _____
19 _____

Was permission obtained from the Conservation Division or
its agents before plugging was commenced? yes

Name of Conservation Agent who supervised plugging of this well Gilbert Balthazor
Producing formation Arb. Depth to top 3835 Bottom 3840 Total Depth of Well 3840
Show depth and thickness of all water, oil and gas formations.

OIL, GAS OR WATER RECORDS

CASING RECORD

FORMATION	CONTENT	FROM	TO	SIZE	PUT IN	PULLED OUT
	Surface	0	248	8 5/8		
		0	3836	4 1/2		3094

Describe in detail the manner in which the well was plugged, indicating where the mud fluid
was placed and the method or methods used in introducing it into the hold. If cement or other
plugs were used, state the character of same and depth placed, from _____ feet to
_____ feet for each plug set.

Filled with sand to 3820 and dumped 4 sx. cement

Pumped top with 130 sx. of 50 50 poz. with 6% jell, pumped in 70
sx. released plug and pumped 60 sx.

STATE CORPORATION COMMISSION
3-14-1977
MAR 14 1977
CONSERVATION DIVISION
Wichita, Kansas

(If additional description is necessary, use BACK of this sheet)

Name of Plugging Contractor Nicholas Casing Pulling

STATE OF Kansas COUNTY OF Rice, ss.
(employee of owner) or (owner or operator)
of the above-described well, being first duly sworn on oath, says: That I have knowledge of
the facts, statements, and matters herein contained and the log of the above-described well
as filed and that the same are true and correct. So help me God.


(Signature) G. A. Nicholas

(Address) _____

SUBSCRIBED AND SWORN TO before me this 11 day of March, 19 77

Carolyn Hass
Carolyn Hass Notary Public.

My commission expires May 7, 1980

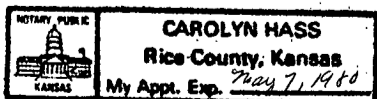

CONTRACTOR'S WELL LOG

OPERATOR:	KEDCO Management Corporation
CONTRACTOR:	Abercrombie Drilling, Inc.
WELL NAME:	GUSTAFSON "A" #1
LOCATION:	SE NE NW, Section 1-10S-22W Graham County, Kansas
SPUD DATE:	December 15, 1976
COMPLETION DATE:	December 23, 1976

0	60	Clay & Sand
60	180	Shale & Sand
180	935	Shale
935	1010	Sand
1010	1315	Shale
1315	1545	Sand
1545	1809	Shale
1809	1843	Anhydrite
1843	2230	Shale
2230	2515	Lime & Shale
2515	3397	Shale & Lime
3397	3840	Lime
	3840	Rotary Total Depth

Spud at 5:00 p.m. 12-15-76. Drilled 250' of 12 1/4" hole. Ran 6 jts. of used 8 5/8" 28# Surface Casing. (Overall tally 240.35') Set at 248.35' K.B. with 165 sx. of common cement, 2% gel, 3% Ca. Cl. (Plug was pumped to 238.85') Plug was down at 9:30 p.m. 12-15-76. Cement did circulate.

T. D. 3840' Preparing to cement longstring. Ran 100 jts. of 4 1/2" - 10 1/2# K-55 Casing. (Tally 3832.35' - Threads Off) Set at 3836.35' with 125 sx. of common cement, 50/50 posmix, salt saturated, 12# Gilsonite. Plug was down at 8:45 a.m. 12-23-76.

SAMPLE TOPS:

Anhydrite 1809' (+521)
B/Anhydrite 1843' (+487)

RECEIVED
STATE CORPORATION COMMISSION
3-1-1977
MAR 01 1977

CONSERVATION DIVISION
Wichita, Kansas

STATE OF KANSAS)
) SS
COUNTY OF SEDGWICK)

Jack L. Partridge, Assistant Secretary-Treasurer of Abercrombie Drilling, Inc., does hereby state that the above and foregoing is a true and correct copy of the log of the GUSTAFSON "A" #1, SE NE NW, Section 1-10S-22W, Graham County, Kansas.

ABERCROMBIE DRILLING, INC.

BY: Jack L. Partridge
Jack L. Partridge, Asst. Sec.-Treas.

Subscribed and sworn to before me, a Notary Public, in and for the aforesaid county and state as of this 27th day of December, 1976.



Kathy S. Goertz
Kathy S. Goertz, Notary Public

COPY