


STATE OF KANSAS
STATE CORPORATION COMMISSION

Give All Information Completely
Make Required Affidavit
Mail or Deliver Report to:
Conservation Division
State Corporation Commission
800 Bitting Building
Wichita, Kansas

WELL PLUGGING RECORD

NORTH

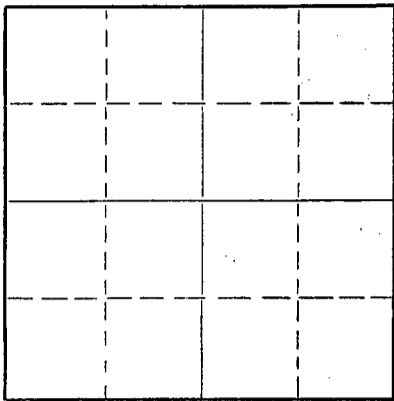

Locate well correctly on above
Section Plat

Graham County, Sec. 1 Twp. 10S Rge. (E) 22(W)

Location as "NE/CNW/SW" or footage from lines NW NW SE
Lease Owner Jones, Shelburne & Farmer, Inc.
Lease Name Holmes C Well No. 1
Office Address Russell, Kansas
Character of Well (completed as Oil, Gas or Dry Hole) Dry
Date well completed 3-4 1953
Application for plugging filed 3-4 1953
Application for plugging approved 3-4 1953
Plugging commenced 3-4 1953
Plugging completed 3-4 1953
Reason for abandonment of well or producing formation Dry

If a producing well is abandoned, date of last production Never produced 19
Was permission obtained from the Conservation Division or its agents before plugging was commenced? yes

Name of Conservation Agent who supervised plugging of this well Eldon Petty
Producing formation _____ Depth to top _____ Bottom _____ Total Depth of Well 3956 Feet
Show depth and thickness of all water, oil and gas formations.

OIL, GAS OR WATER RECORDS

CASING RECORD

FORMATION	CONTENT	FROM	TO	SIZE	PUT IN	PULLED OUT
				8 5/8	164	none

Describe in detail the manner in which the well was plugged, indicating where the mud fluid was placed and the method or methods used in introducing it into the hole. If cement or other plugs were used, state the character of same and depth placed, from _____ feet to _____ feet for each plug set.

1. Filled hole with heavy mud
2. Pushed plug to 160'
3. Dumped 1/2 sack hulls on top of plug
4. Mixed 15 sacks cement and dumped on top of hulls
5. Filled hole to top
6. Pushed plug to 40'
7. Dumped in 1/2 sack hulls
8. Mixed 10 sacks cement and filled hole to top with same


(If additional description is necessary, use BACK of this sheet)

Name of Plugging Contractor Jones, Shelburne & Farmer, Inc.
Address Russell, Kansas

STATE OF Kansas, COUNTY OF Russell, ss.
John O. Farmer (employee of owner) or (owner or operator) of the above-described well, being first duly sworn on oath, says: That I have knowledge of the facts, statements, and matters herein contained and the log of the above-described well as filed and that the same are true and correct. So help me God.

(Signature) John O. Farmer
(Address) _____

SUBSCRIBED AND SWORN TO before me this 5th day of March, 1953
My commission expires April 23, 1956
Bonnie Berryhill Notary Public.

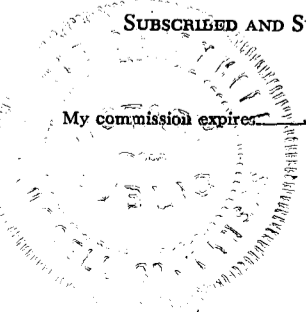

24-2675-S 2-52-20M
PLUGGING
FILE SEC 1 T 10 R 22b
BOOK PAGE 22 LINE 28

RECEIVED
3-6-1953
CONSERVATION DIVISION

OPERATOR Jones, Shelburne & Farmer, Inc.

ADDRESS Russell, Kansas

Give detailed description and thickness of all formations drilled through, contents of sand, whether dry, water, oil or gas.

640 Acres
N

COUNTY Graham SEC. 1 TWP. 10S RGE. 22W

COMPANY OPERATING Jones, Shelburne & Farmer, Inc.

OFFICE ADDRESS Russell, Kansas

FARM NAME Holmes C WELL NO. 1

DRILLING STARTED 2-19-53 DRILLING FINISHED 3-4-1953


DATE OF FIRST PRODUCTION _____ COMPLETED _____

WELL LOCATED NW 1/4 NW 1/4 SE 1/4 North of South

Line and _____ ft. East of West Line of Quarter Section

Elevation (Relative to sea level) DERRICK FLOOR 2316 GROUND

CHARACTER OF WELL (Oil, gas or dryhole) Dry

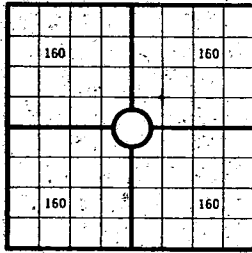

OIL OR GAS SANDS OR ZONES

Name	From	To	Name	From	To
1			4		
2			5		
3			6		

Perforating Record If Any

Shot Record

Formation	From	To	No. of Shots	Formation	From	To	Size of Shot

CASING RECORD

Amount Set						Amount Pulled			Packer Record		
Size	Wt.	Thick.	Make	Ft.	In.	Ft.	In.	Size	Length	Depth Set	Make
8 5/8	26	8	smls	164				none			

Liner Record: Amount _____ Kind _____ Top _____ Bottom _____

CEMENTING AND MUDDING

Size	Amount Set		Sacks Cement	Chemical		Method of Cementing	Amount	Mudding Method	Results (See Note)
	Ft.	In.		Gal.	Make				
8 5/8	164		100						

Note: What method was used to protect sands if outer strings were pulled? _____

NOTE: Were bottom hole plugs used? _____ If so, state kind, depth set and results obtained _____

TOOLS USED

Rotary Tools were used from _____ feet to _____ Cable tools were used from _____ feet to _____ feet, and from _____ feet to _____ feet, and from _____ feet to _____ feet.

Type Rig _____

INITIAL PRODUCTION TEST

Describe initial test: whether by flow through tubing or casing or by pumping _____

Amount of Oil Production _____ bbls. Size of choke, if any _____ Length of test _____ Water

Production _____ bbls. Gravity of oil _____ Type of Pump if pump is used, describe _____

Formation	Top	Bottom	Formation	Top	Bottom
Sand & shale	0	160			
Shale	160	400			
Shale & shells	400	1175			
Shale, shells & sand	1175	1550			
Shale & shells	1550	1787			
Anhydrite	1787	1830			
Shale & shells	1830	2560			
Lime & shale	2560	3135			
Shale & lime	3135	3230			
Lime & shale	3230	3590			
Lime	3590	3735			
Lime & shale	3735	3926			
Dolomite	3926	3956			

PLUGGING
 FULL SEC 1-12-R-22W
 BOOK PAGE 12-LINE 38

RECEIVED
 STATE OF KANSAS
 3-6-1953
 MAR

CONSERVATION DIVISION
 W-100, 4-1-50s

TOPS:

Elevation 2318 R. B.
 Heebner 3510
 Toronto 3534
 Lansing 3549
 Arbuckle 3926
 Total Depth 3956
 D & A

I, the undersigned, being first duly sworn upon oath, state that this well record is true, correct and complete according to the records of this office and to the best of my knowledge and belief.

John Farmer Vice-P
 Name and title of representative of company

Subscribed and sworn to before me this 5th day of March 1953
 My Commission expires April 23, 1956
Bonnie Perryhill
 Notary Public

22W RGE
 15-065-00277-00-00
 SEC. 1
 TWP. 10S
 COUNTY Graham
 WELL NO. Holmes C
 FARM NAME