


Give All Information Completely
Make Required Affidavit
Mail or Deliver Report to:
Conservation Division
State Corporation Commission
212 No. Market
Wichita, Kansas

WELL PLUGGING RECORD

NORTH

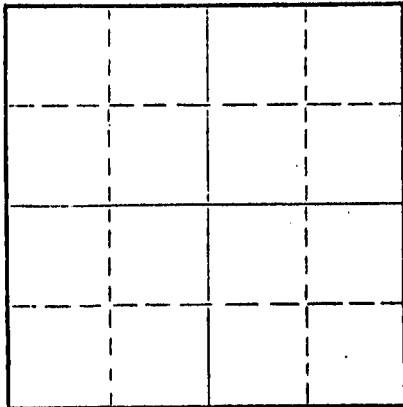

Locate well correctly on above
Section Plat

Graham County. Sec 2 Twp. 10 Rge. 22 (E) (W)
Location as "NE/CNW/SW" or footage from lines C n/2 SW NE
Lease Owner Shallow Water Refining Company
Lease Name Brassfield Well No. 4
Office Address Wichita, Kansas
Character of Well (completed as Oil, Gas or Dry Hole) _____
Date well completed _____ 19____
Application for plugging filed _____ 19____
Application for plugging approved _____ 19____
Plugging commenced 3/31/67 _____ 19____
Plugging completed 4/ 1/67 _____ 19____
Reason for abandonment of well or producing formation depleted.

If a producing well is abandoned, date of last production _____ 19____
Was permission obtained from the Conservation Division or its agents before plugging was commenced? yes

Name of Conservation Agent who supervised plugging of this well Nichols
Producing formation _____ Depth to top _____ Bottom _____ Total Depth of Well 3786 Feet
Show depth and thickness of all water, oil and gas formations.

OIL, GAS OR WATER RECORDS

CASING RECORD

FORMATION	CONTENT	FROM	TO	SIZE	PUT IN	PULLED OUT
				8 5/8	225	none
				4 1/2	3786	663

Describe in detail the manner in which the well was plugged, indicating where the mud fluid was placed and the method or methods used in introducing it into the hole. If cement or other plugs were used, state the character of same and depth placed, from _____ feet to _____ feet for each plug set.

Sanded hole to 3680' and ran 3 sacks of cement. Shot pipe at 797', 731', 672'.
Pulled pipe to 600' and pumped 17 sacks of mud. Pumped 20 sacks of cement.
Pumped 20 more sacks of cement. Talled pipe, capped hole with 10 sacks of
cement.

PLUGGING COMPLETE.

RECEIVED
4-7-1967
APR 7 1967

(If additional description is necessary, use BACK of this sheet)

Name of Plugging Contractor KNIGHT CASING PULLING COMPANY
Address CHASE, KANSAS

STATE OF KANSAS COUNTY OF RICE, ss.
NOEL J. KNIGHT (employee of owner) or (owner or operator) of the above-described well, being first duly sworn on oath, says: That I have knowledge of the facts, statements, and matters herein contained and the log of the above-described well as filed and that the same are true and correct. So help me God.

(Signature) Noel Knight
CHASE, KANSAS
(Address)

SUBSCRIBED AND SWORN TO before me this 3rd day of April, 1967

Margaret M. Fisher
Notary Public.

My commission expires February 15, 1971

W E L L L O G

OPERATOR:	K & E, BROWN & FORTIER 719 Union Center Wichita 2, Kansas	LOCATION:	CN/2 SW NE Sec. 2-10S-22W Graham County, Kansas
CONTRACTOR:	K & E DRILLING, INC. 719 Union Center Building Wichita, Kansas	FARM NAME:	BRASSFIELD #4
CASING:	8-5/8" @ 225 (150 sx) 4-1/2" @ 3786 (150 sx)	COMMENCED:	2-22-57
R.T.D.	k 3790 RTD	COMPLETED:	3-2-57
		PRODUCTION:	OIL - Lansing
		ELEVATION:	2319' KB

FORMATION RECORD

Depths shown indicate bottom of formation encountered

Sand & Shale	110
Shale	780
Shale & Sand	1300
Sand	1540
Red Bed & Shale	1800
Anhydrite	1840
Shale & Shells	2210
Shale & Lime	2990
Lime & Shale	3015
Shale & Lime	3440
Lime	3790
R.T.D.	3790

RECEIVED
 OIL & GAS COMMISSION
 FEB 24 1967
 CONSTRUCTION DIVISION
 WICHITA, KANSAS

CERTIFICATION

STATE OF KANSAS }
 COUNTY OF SEDGWICK } SS:

I, Dale Silcott of the K & E DRILLING, INC., upon oath state that the above and foregoing is a true and correct copy of the log of the #4 BRASSFIELD well.

Dale Silcott

 Dale Silcott

Subscribed and sworn to before me this 4th day of March, 1957

Patricia M. Edwards

 Patricia M. Edwards, Notary Public

My commission expires: 11 August 1958.

