


STATE OF KANSAS  
STATE CORPORATION COMMISSION

Form CP-4

Give All Information Completely  
Make Required Affidavit  
Mail or Deliver Report to:  
Conservation Division  
State Corporation Commission  
212 No. Market  
Wichita, Kansas

WELL PLUGGING RECORD

NORTH

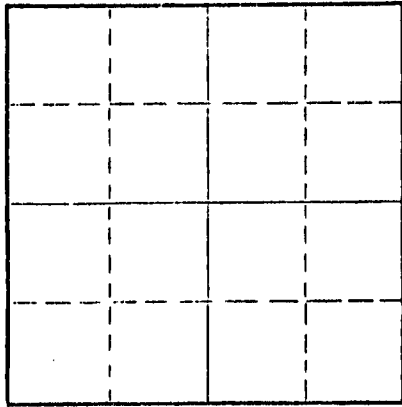

Locate well correctly on above  
Section Plat

Graham County, Sec. 2 Twp. 10 Rge. 22 (E) (W)  
Location as "NE/CNW/SW" or footage from lines N W. N W. N E  
Lease Owner Spector Pipe & Supply, Inc.  
Lease Name Brassfield Well No. 1  
Office Address Russell, Kansas  
Character of Well (completed as Oil, Gas or Dry Hole) Oil  
Date well completed 7-5-56 19  
Application for plugging filed Feb. 21, 1968 19  
Application for plugging approved Feb. 22, 1968 19  
Plugging commenced 3/5 19 68  
Plugging completed 3/9 19 68  
Reason for abandonment of well or producing formation Dry

If a producing well is abandoned, date of last production ? 19  
Was permission obtained from the Conservation Division or its agents before plugging was commenced? Yes

Name of Conservation Agent who supervised plugging of this well Bill Nichols  
Producing formation Kansas City Depth to top 3782 Bottom 3814 ft. Total Depth of Well 3934 Feet  
Show depth and thickness of all water, oil and gas formations.

OIL, GAS OR WATER RECORDS

CASING RECORD

FORMATION	CONTENT	FROM	TO	SIZE	PUT IN	PULLED OUT
				8 5/8" OD	224 ft.	none
				4 1/2" OD	3814 ft.	679 ft.

Describe in detail the manner in which the well was plugged, indicating where the mud fluid was placed and the method or methods used in introducing it into the hole. If cement or other plugs were used, state the character of same and depth placed, from \_\_\_\_\_ feet to \_\_\_\_\_ feet for each plug set.

Plugged Back to 3500 with sand, 3 sacks cement.  
Pumped 4 Sacks Hulls, 35 sacks mud, & 100 sacks cement to Top.

RECEIVED  
STATE CORPORATION COMMISSION  
MAR 20 1968  
CONSERVATION DIVISION  
Wichita, Kansas

(If additional description is necessary, use BACK of this sheet)  
Name of Plugging Contractor Lynch Casing Pulling  
Address Rt # 4 Great Bend, Kansas 67630

STATE OF Kansas, COUNTY OF Russell, ss.  
Spector Pipe & Supply, Inc. (employee of owner) or (owner or operator) of the above-described well, being first duly sworn on oath, says: That I have knowledge of the facts, statements, and matters herein contained and the log of the above-described well as filed and that the same are true and correct. So help me God.

(Signature) [Signature]  
Russell, Kansas  
(Address)

SUBSCRIBED AND SWORN TO before me this 19th day of March, 1968


My commission expires May 21, 1971  
Wilma M. Lindahl Notary Public.

15-065-00922-00-00

Company- K & E DRILG. INC., EUGENE BROWN, LEO FORTIER SEC. 2 T. 10 R22W  
 Farm- Brassfield No. 1 NW NW NE

Total Depth. 3934'  
 Comm. 6-25-56 Comp. 7-5-56  
 Shot or Treated.  
 Contractor.  
 Issued. 10-12-57

County Graham  
 KANSAS

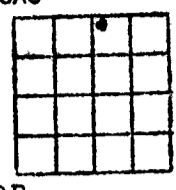

CASING:  
 8 5/8" 224' w/150 sx cem.  
 4 1/2" 3811' w/125 sx cem.

Elevation. 2332' RB  
 Production. 364 BOPD

Figures indicate Bottom of Formations.

cellar	8
clay	30
sand-clay	75
shale	935
shale-sand	1340
sand	1554
redbed	1710
red bed-shale	1810
Anhydrite	1850
shale-shells	2265
lime-shale	3455
lime	3765
lime-shale	3835
lime	3898
lime-shale	3934
Total Depth	
TOPS: Scout	
Anhydrite	1810
Heebner	3514
Toronto	3538
Lansing	3552
B/Kansas City	3782
Arbuckle	3922

RECEIVED  
 STATE CORPORATION COMMISSION  
 7-26-1968  
 FEB 26 1968  
 CONSERVATION DIVISION  
 Wichita, Kansas