

15-065-03222-0000

STATE OF KANSAS
STATE CORPORATION COMMISSION

WELL PLUGGING RECORD

Give All Information Completely
Make Required Affidavit
Mail or Deliver Report to:
Conservation Division
State Corporation Commission
800 Bitting Building
Wichita, Kansas

Graham County. Sec. 33 Twp. 10S Rge. (X) 23 (W)

Location as "NE/CNW%SW%" or footage from lines C NE SE NW

Lease Owner Gulf Oil Corporation

Lease Name M. Walker Well No. 2

Office Address Box 661, Tulsa, Oklahoma

Character of Well (completed as Oil, Gas or Dry Hole) oil

Date well completed 11-29 19 55

Application for plugging filed 7-18 19 57

Application for plugging approved 7-22 19 57


Plugging commenced 8-7 19 57

Plugging completed 8-10 19 57

Reason for abandonment of well or producing formation Well operating below its economic limit

If a producing well is abandoned, date of last production 7-10 1957

Was permission obtained from the Conservation Division or its agents before plugging was commenced? yes

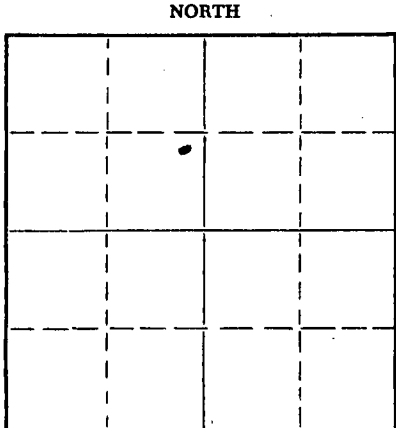

Locate well correctly on above Section Plat

Name of Conservation Agent who supervised plugging of this well Eldon Petty

Producing formation Lansing-Kansas City Depth to top 3590' Bottom 3850' Total Depth of Well 3810' Feet

Show depth and thickness of all water, oil and gas formations. PB from 3850'

OIL, GAS OR WATER RECORDS

CASING RECORD

FORMATION	CONTENT	FROM	TO	SIZE	PUT IN	PULLED OUT
				8-5/8"	267'	-0-
				5 1/2"	3848'	3036'

Describe in detail the manner in which the well was plugged, indicating where the mud fluid was placed and the method or methods used in introducing it into the hole. If cement or other plugs were used, state the character of same and depth placed, from _____ feet to _____ feet for each plug set.

Fill with sand to 3600' and with 4 sacks cement to 3568'. Fill with mud to 260'. Set rock bridge. Dumped 20 sacks cement on bridge. Mudded to 35'. Set rock bridge and filled to base of cellar with 10 sacks cement.

(If additional description is necessary, use BACK of this sheet)

Name of Plugging Contractor Morgan Well Plugging Service

Address 102 W. 18th, Hutchinson, Kansas

STATE OF Kansas, COUNTY OF Sedgwick, ss.


Thomas A. Trax (employee of owner) or (owner or operator) of the above-described well, being first duly sworn on oath, says: That I have knowledge of the facts, statements, and matters herein contained and the log of the above-described well as filed and that the same are true and correct. So help me God.

(Signature) Thomas A. Trax
THOMAS A. TRAX - Area Prod. Supt.
Box 2233, Wichita, Kansas
(Address)

SUBSCRIBED AND SWORN TO before me this 13th day of August, 1957

My commission expires 6-3-61

C. C. LEWIS, Notary Public.

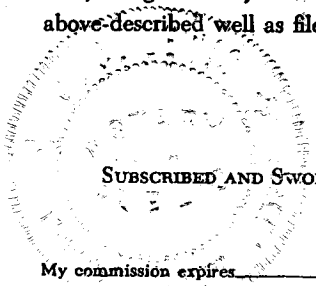

PLUGGING
FILE SEC 33 T 10 R 23W
BOOK PAGE 29 LINE 18

AUG 14 1957
8-14-57
CONSERVATION DIVISION

JRM:JM
8-12-57

15-065-03222-0000

RECEIVED
STATE CORPORATION COMMISSION
JUL 20 1957

MILDRED WALKER NO. 2

NE SE 1/4 Section 33-10S-23W
Graham County, Kansas
Gulf Oil Corporation

CONSERVATION DIVISION
Wichita, Kansas

8-5/8" O. D. casing cemented at 237'
5-1/2" O. D. casing cemented at 3047.53'

Drilling commenced October 30, 1955
Drilling completed November 11, 1955

FROM	TO	FORMATION	REMARKS
0'	270'	Sand & shale	8-5/8" O. D. casing cemented with 200 sacks cement at 237'
270	570	Shale & shells	
570	700	Sand & shale	
700	850	Shale & shells	
850	1350	Shale & sand	
1350	1585	Sand	
1585	1810	Shale & shells	
1810	1875	Anhydrite	
1875	2460	Shale & shells	
2460	2485	Shale & lime streaks	
2485	2660	Lime & shale	
2660	3000	Shale & lime	
3000	3090	Lime	
3090	3170	Shale & lime	
3170	3535	Lime	
3535	3600	Lime & shale	
3600	3850	Lime	5-1/2" O. D. casing cemented with 100 sacks cement at 3047.53'

T.D. 3850'

PLUGGING
 FILE SEC 33 T. 10 R. 23W
 BOOK PAGE 29 L. 10