

15-065-03221-0006


STATE OF KANSAS
STATE CORPORATION COMMISSION

Give All Information Completely
Make Required Affidavit
Mail or Deliver Report to:
Conservation Division
State Corporation Commission
211 No. Broadway
Wichita, Kansas

WELL PLUGGING RECORD

Graham County. Sec. 33 Twp. 10S Rge. 8 (E) 23 (W)
Location as "NE/CNW/SW" or footage from lines NE NE NW
Lease Owner Gulf Oil Corporation
Lease Name M. Walker Well No. 1
Office Address Box 661, Tulsa, Oklahoma
Character of Well (completed as Oil, Gas or Dry Hole) oil
Date well completed 10-19 19 55
Application for plugging filed 7-18 19 57
Application for plugging approved 7-22 19 57
Plugging commenced 8-2 19 57
Plugging completed 8-5 19 57
Reason for abandonment of well or producing formation Well was operating below its economic limit.
If a producing well is abandoned, date of last production 7-10 19 57
Was permission obtained from the Conservation Division or its agents before plugging was commenced? yes

NORTH

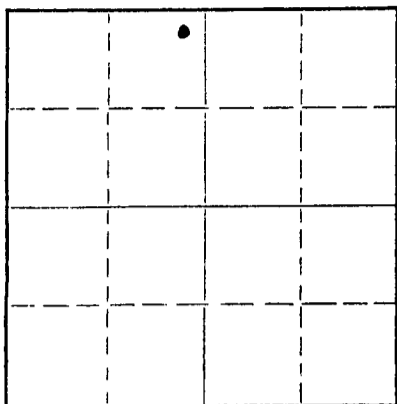

Locate well correctly on above Section Plat

Name of Conservation Agent who supervised plugging of this well Eldon Petty
Producing formation Lansing-Kansas City Depth to top 3613 Bottom 3865' Total Depth of Well 3865 Feet
Show depth and thickness of all water, oil and gas formations. PB from 4096'

OIL, GAS OR WATER RECORDS

CASING RECORD

FORMATION	CONTENT	FROM	TO	SIZE	PUT IN	PULLED OUT
				8-5/8"	257'	-0-
				5-1/2"	3901'	2992.5'

Describe in detail the manner in which the well was plugged, indicating where the mud fluid was placed and the method or methods used in introducing it into the hole. If cement or other plugs were used, state the character of same and depth placed, from _____ feet to _____ feet for each plug set.

Filled with sand from 3865'-3760'. Dumped 4 sacks cement from 3760'-3728'. Filled hole with mud to 257' in surface pipe. Dumped 20 sacks cement filled with mud to 35' and capped with 10 sacks cement filling hole into cellar.

STATE CORPORATION COMMISSION
WICHITA, KANSAS
AUG 10 1957
08-10-57

(If additional description is necessary, use BACK of this sheet)

Name of Plugging Contractor Morgan Well Plugging Service
Address 102 W. 18th St., Hutchinson, Kansas

STATE OF Kansas, COUNTY OF Sedgwick, ss.
Thomas A. Trax (employee of owner) ~~(owner or operator)~~ of the above-described well, being first duly sworn on oath, says: That I have knowledge of the facts, statements, and matters herein contained and the log of the above-described well as filed and that the same are true and correct. So help me God.

(Signature) Thomas A. Trax
THOMAS A. TRAX - Area Prod. Supt.
Box 2233, Wichita, Kansas
(Address)

SUBSCRIBED AND SWORN TO before me this 7th day of August, 19 57

My Commission expires 6-3-61

C. C. Lewis
Notary Public.

JHM:JM

PLUGGING
FILE SEC 33 T. 10 R. 23W
BOOK PAGE 29 LINE 16

15-065-03221-0000

MILDRED WALKER NO. 1

NE NE NW Section 33-10S-23W
Graham County, Kansas
Gulf Oil Corporation

RECEIVED
STATE CORPORATION COMMISSION

JUL 20 1957
CONSERVATION DIVISION
Wichita, Kansas

Drilling commenced September 27, 1955
Drilling completed October 12, 1955

8-5/8" C. D. casing cemented at 256'
5-1/2" O. D. casing cemented at 3894'

FROM	TO	FORMATION	REMARKS
0'	90'	Shale & shells	
90	160	Sand	
160	440	Shale & shells	8-5/8" C. D. casing cemented with 200 sacks cement at 256'
440	890	Shale	
890	910	Iron	
910	950	Sand & iron	
950	1185	Shale, sand & iron	
1185	1360	Shale, red bed & shells	
1360	1625	Sand	
1625	1875	Shale & shells	
1875	1905	Anhydrite	
1905	2230	Shale & shells	
2230	2280	Salt	
2280	2345	Shale & shells	
2345	2370	Lime & shale	
2370	2555	Shale & lime	
2555	2690	Lime & shale	
2690	2805	Shale & lime	
2805	2950	Lime & shale	
2950	3010	Lime	
3010	3245	Shale & lime	
3245	3610	Lime & shale	
3610	3613	Shale	
3613	3653	K. C. lime	
3653	3690	Lime & shale	
3690	3705	Lime	
3705	3895	Lime & shale	Coring 3774' - 3804'
3895	3945	Shale & lime	
3945	3980	Lime & chert	
3980	4025	Shale, lime & chert	
4025	4042	Lime & shale	
4042	4075	Conglomerate	
4075	4096	Chert & lime	5-1/2" O. D. casing cemented with 175 sacks cement at 3894'

T.D. 4096'

PLUGGING

FILE SEC. 23 T 10 R 23W
BOOK PAGE 29 LINE 15