


STATE OF KANSAS  
STATE CORPORATION COMMISSION

WELL PLUGGING RECORD

Give All Information Completely  
Make Required Affidavit  
Mail or Deliver Report to:  
Conservation Division  
State Corporation Commission  
212 North Market, Insurance Bldg.  
Wichita, Kansas

NORTH

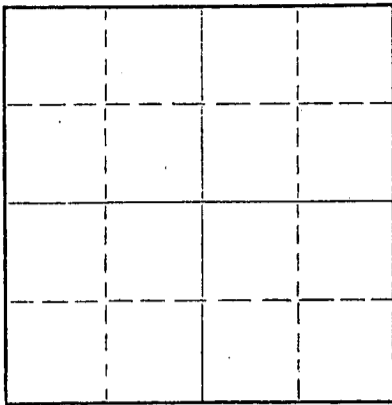

Locate well correctly on above  
Section Plat

Graham County. Sec. 15 Twp. 10S Rge. 22W (E) (W)  
Location as "NE/CNWxSWx" or footage from lines. SE SW SE  
Lease Owner Imperial Oil of Kansas, Inc.  
Lease Name Griffith Well No. 1  
Office Address 780 Fourth National Bldg., Wichita 2, Kansas  
Character of Well (completed as Oil, Gas or Dry Hole) Oil Well  
Date well completed \_\_\_\_\_ 19\_\_\_\_  
Application for plugging filed \_\_\_\_\_ 19\_\_\_\_  
Application for plugging approved \_\_\_\_\_ 19\_\_\_\_  
Plugging commenced August 18 19 59  
Plugging completed August 18 19 59  
Reason for abandonment of well or producing formation Commercial quantities  
of oil depleted.  
If a producing well is abandoned, date of last production August 17 19 59  
Was permission obtained from the Conservation Division or its agents before plugging was com-  
menced? Yes

Name of Conservation Agent who supervised plugging of this well Mr. A. D. Fabricius  
Producing formation \_\_\_\_\_ Depth to top \_\_\_\_\_ Bottom \_\_\_\_\_ Total Depth of Well 3921 Feet  
Show depth and thickness of all water, oil and gas formations.

OIL, GAS OR WATER RECORDS

CASING RECORD

FORMATION	CONTENT	FROM	TO	SIZE	PUT IN	PULLED OUT

Describe in detail the manner in which the well was plugged, indicating where the mud fluid was placed and the method or methods used in introducing it into the hole. If cement or other plugs were used, state the character of same and depth placed, from \_\_\_\_\_ feet to \_\_\_\_\_ feet for each plug set.

Filled hole with mud to 220', set 10' rock bridge.  
Mixed and run 25 sacks cement, mud to 40', set 10'  
rock bridge. Mixed and run 10' sacks of cement to  
base of cellar.

RECEIVED  
STATE CORPORATION COMMISSION  
3-22-1960  
MAR 22 1960  
CONSERVATION DIVISION  
Wichita, Kansas

(If additional description is necessary, use BACK of this sheet)  
Name of Plugging Contractor Southwest Casing Pulling Company  
Address P. O. Box 364, Great Bend, Kansas

STATE OF KANSAS, COUNTY OF SEDGWICK, ss.  
K. J. Boone (employee of owner) or (owner or operator) of the above-described well, being first duly sworn on oath, says: That I have knowledge of the facts, statements, and matters herein contained and the log of the above-described well as filed and that the same are true and correct. So help me God. IMPERIAL OIL OF KANSAS, INC.  
(Signature) By: K. J. Boone Pet. Engr.  
780 Fourth National Bldg., Wichita 2, Kansas  
(Address)

SUBSCRIBED AND SWORN TO before me this 16th day of March, 19 60  
Mona L. Fisher  
My commission expires July 7, 1962 Notary Public.

