

15-065-00256-00-00

STATE OF KANSAS
STATE CORPORATION COMMISSION


Give All Information Completely
Make Required Affidavit
Mail or Deliver Report to:
Conservation Division
State Corporation Commission
800 Bittling Building
Wichita, Kansas

WELL PLUGGING RECORD

Graham County, Sec. 9 Twp. 10 Rge. 23W (E) (W)

Location as "NE/CNW $\frac{1}{4}$ SW $\frac{1}{4}$ " or footage from lines NW NW SW
Lease Owner Harry Gore
Lease Name Hoof Well No. 1
Office Address 400 Brown Bldg., Wichita, Kansas.
Character of Well (completed as Oil, Gas or Dry Hole) Dry Hole
Date well completed 9-17-51 19
Application for plugging filed 9-17-51 19
Application for plugging approved 9-17-51 19
Plugging commenced 9-17-51 19
Plugging completed 9-17-51 19
Reason for abandonment of well or producing formation Dry Hole

NORTH

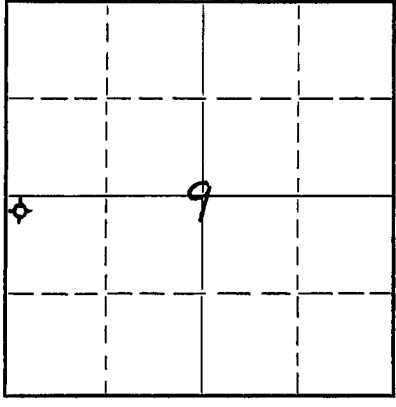

Locate well correctly on above Section Plat

If a producing well is abandoned, date of last production 19
Was permission obtained from the Conservation Division or its agents before plugging was commenced? yes

Name of Conservation Agent who supervised plugging of this well Eldon Petty
Producing formation Depth to top Bottom Total Depth of Well 4280 Feet
Show depth and thickness of all water, oil and gas formations.

OIL, GAS OR WATER RECORDS

CASING RECORD

Formation	Content	From	To	Size	Put In	Pulled Out
Surface		0	172	8 5/8"	172	0

Describe in detail the manner in which the well was plugged, indicating where the mud fluid was placed and the method or methods used in introducing it into the hole. If cement or other plugs were used, state the character of same and depth placed, from feet to feet for each plug set.

Set 1 - Jt. plug at 160' cemented with 15 sacks cement - Set 2nd Plug at 40' one half sack hulls on top cemented with 10 sacks cement

9-26-1951

(If additional description is necessary, use BACK of this sheet)

Name of Plugging Contractor Empire drilling Company
Address 1121 Union National Bank Bldg., Wichita, Kansas.

STATE OF Kansas COUNTY OF Sedgewick, ss.
Dan J. Barnfield (employee of owner) or (owner or operator) of the above-described well,

being first duly sworn on oath, says: That I have knowledge of the facts, statements, and matters herein contained and the log of the above-described well as filed and that the same are true and correct. So help me God.

(Signature) Empire Drilling Co
Dan J. Barnfield (Address)

SUBSCRIBED AND SWORN TO before me this 25th day of September, 1951
Charlotte Fletcher Notary Public.

My commission expires June 7, 1952

23-8390-s 6-51-20M

PLUGGING

FILE SEC 9 T 10 R 23W

BOOK PAGE 10 LINE 29

COMPANY: Harry Gore
 CONTRACTOR: Empire Drilling Company
 FARM: Hoof No. 1
 LOCATION: NW NW SW Sec. 9-10-23W
 Graham County, Kansas
 COMMENCED: August 31, 1951.
 COMPLETED: September 17, 1951.

0	to	60	Clay & Shells
60	to	80	Sand
80	to	193	Shale & Sand
193	to	524	Shale, Sand & Shells
524	to	1300	Shale & Shells
1300	to	1740	Shale, Shells & Sand
1740	to	1950	Shale & Shells
1950	to	2015	Anhydrite
2015	to	2155	Shale & Shells
2155	to	2300	Lime & Shale
2300	to	2570	Shale & Lime
2570	to	2670	" "
2670	to	2960	" "
2960	to	3190	Lime & Shale
3190	to	3506	Lime & Shale SLM 3279 = 3379
3506	to	3690	Lime & Shells
3690	to	3780	Lime
3780	to	3864	Lime
3864	to	3945	Lime
3945	to	3973	Lime & Shale
3973	to	3992	Shale
3992	to	4017	Shale & Lime
4017	to	4039	Cherty Lime
4039	to	4075	Shale
4075	to	4115	Shale & Lime
4115	to	4150	Shale & Lime
4150	to	4174	Shale & Chert
4174	to	4186	Chert
4186	to	4229	Chert, Shale & Lime
4229	to	4276	Arbuckle
4276	to	4280	Arbuckle T. D. Rotary

Set 166' 8-5/8" Surface Pipe. Cemented with 130 sacks of cement.

Drill Stem Test: 3706-3725-3780-3887.

Ran Schlumberger Electric Log at 4280'.

Tops: Topeka 3424', Heebner 3646', Brown Lime 3666', Lansing

K.C. 3677', Base K. G. 3904', Marmaton Cong. 3993,

Cherty Cong. 4101', White Chert 4161', Arbuckle 4225'.

All measurements from rig floor 3-feet below bushings.

Elevation: 2382' D. F.

DRY

9-26-1951
 SEP 26 1951

C E R T I F I C A T E

I, Dan J. Kornfeld, do hereby certify that the above and foregoing is a true and correct copy of the log of the Hoof No. 1 in Sec. 9-10-23W, Graham County, Kansas, as reflected by files of the Empire Drilling Company.

PLUGGING

FILE SEC 9-10-R³³⁰
 110-11-29

Dan J. Kornfeld
 Dan J. Kornfeld

Subscribed and sworn to before me a Notary Public, within and for Sedgwick County, Kansas, this 24 day of September, 1951.

Evelyn V. North
 Evelyn V. North
 Notary Public

My commission expires Dec. 22, 1954.

