


15-065-02609-00-00

WELL PLUGGING RECORD

Give All Information Completely
Make Required Affidavit
Mail or Deliver Report to:
Conservation Division
State Corporation Commission
800 Biting Building
Wichita, Kansas

Graham County, Sec. 9 Twp. 10S Rge. (E) 23 (W)

Location as "NE/CNW/SW" or footage from lines NW 1/4 NE 1/4 SE 1/4
Lease ~~owner~~ Operator: Birmingham-Bartlett Drilling Co.
Lease Name Johnson "E" Well No. 6
Office Address 300 Kaufman Bldg., Wichita 2, Kansas
Character of Well (completed as Oil, Gas or Dry Hole) Dry Hole
Date well completed December 6 19 55
Application for plugging filed (Verbally approved) December 8 19 55
Application for plugging approved (" " ") 19 55
Plugging commenced December 6 19 55
Plugging completed December 6 19 55
Reason for abandonment of well or producing formation Dry Hole

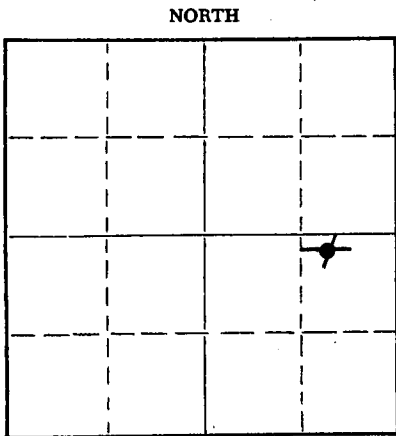

Locate well correctly on above Section Plat

If a producing well is abandoned, date of last production _____ 19 _____

Was permission obtained from the Conservation Division or its agents before plugging was commenced? Yes

Name of Conservation Agent who supervised plugging of this well Eldon Petty

Producing formation _____ Depth to top _____ Bottom _____ Total Depth of Well 3835 Feet

Show depth and thickness of all water, oil and gas formations.

OIL, GAS OR WATER RECORDS

CASING RECORD

FORMATION	CONTENT	FROM	TO	SIZE	PUT IN	PULLED OUT
				8-5/8	249'	None

Describe in detail the manner in which the well was plugged, indicating where the mud fluid was placed and the method or methods used in introducing it into the hole. If cement or other plugs were used, state the character of same and depth placed, from _____ feet to _____ feet for each plug set.

Plugged hole with 15 sacks cement on bottom plug set at 240'; 10 sacks on top plug set at 40'.

(If additional description is necessary, use BACK of this sheet)

Name of Plugging Contractor Birmingham-Bartlett Drilling Co.
Address (Given above)

STATE OF KANSAS, COUNTY OF SEDGWICK
Richard Hindery, partner of Birmingham-Bartlett Drilling Co., contractor and operator (employee of owner) or (owner or operator) of the above-described well, being first duly sworn on oath, says: That I have knowledge of the facts, statements, and matters herein contained and the log of the above-described well as filed and that the same are true and correct. So help me God. BIRMINGHAM-BARTLETT DRILLING CO.

(Signature) By Richard Hindery, Partner
300 Kaufman Bldg., Wichita 2, Kansas
(Address)

SUBSCRIBED AND SWORN TO before me this 8th day of December, 19 55.

My commission expires November 29, 1958.

Vivian F. Yinger
Vivian F. Yinger, Notary Public.

FILED
DEC 9 10 R 23w
BOOK PAGE 22 LINE 30

12-9-1955

JOHNSON #6 WELL

LOCATION: NW $\frac{1}{4}$ NE $\frac{1}{4}$ SE $\frac{1}{4}$ 9-10S-23W
 Graham County, Kansas

SPUDDED: 11-29-55

OPERATOR and CONTRACTOR: Birmingham-Bartlett Drilling Co.
 300 Kaufman Bldg., Wichita, Kansas

COMPLETED: 12-6-55

SURFACE CASING: 8-5/8" surface casing set at 249'
 with 175 sacks cement and 3 c.c.

OIL STRING: None Set. Dry, Abandoned & Plugged

LOG

(Figures indicate bottom of formation)

0 -	85	Clay & Shale
	1100	Shale
	1300	Sand
	1523	Red Bed
	1955	Red Bed & Shells
	1980	Anhydrite
	2245	Shale & Shells
	2420	Shale
	2431	Lime
	3603	Lime & Shale
	3835	Lime
	3835	RTD - D & A

The undersigned, Richard Hindery, one of the partners of Birmingham-Bartlett Drilling Co., hereby certifies that the above is a true and correct log of the formations encountered in drilling the Johnson "E" #6 Well as shown in the daily drilling reports.

BIRMINGHAM-BARTLETT DRILLING CO.

By Richard Hindery
Richard Hindery, Partner

Subscribed and sworn to before me this 8th day of December, 1955.

Vivian F. Yinger
Vivian F. Yinger - Notary Public

My commission expires November 29, 1958.

12-9-1955

PLUGGING
 FILE SEC-9 T 10 R 23W
 BOOK PAGE 22 LINE 30