

AFFIDAVIT AND COMPLETION FORM

ACO-1


This form must be filed in triplicate with the Kansas Corporation Commission, 200 Colorado Derby Building, Wichita, Kansas 67202, within five days after the completion of the well, regardless of how the well was completed. Circle one: Oil, gas, dry, SWD, OWWO, injection. Please type. Complete ALL sections. Applications must be filed for dual completion, commingling, salt water disposal and injection. Attach wireline logs (i.e. electrical log, sonic log, gamma ray neutron log, etc.) KCC#-(316) 263-3238.

OPERATOR Don E. Pratt API NO. 15-065-21,521
ADDRESS P.O. Box 370 COUNTY Graham
Hays, KS 67601 FIELD Riedel
\*\*CONTACT PERSON Don E. Pratt LEASE Denio
PHONE 913-625-3446

PURCHASER Charter International Oil Co., WELL NO. 5-5
ADDRESS P.O. Box 5008, Houston, TX WELL LOCATION 100' NEC SW/4

DRILLING CONTRACTOR Murfin Drilling Co.,
ADDRESS 617 Union Center
Wichita, KS 67202
Ft. from Line and
Ft. from Line of
the NW/4 SEC 5 TWP. 10 RGE. 24 W

PLUGGING CONTRACTOR (None--Commercial Producer)
ADDRESS
TOTAL DEPTH 4090' PBTB
SPUD DATE 10-17-81 DATE COMPLETED 10-24-81
ELEV: GR DF KB 2533

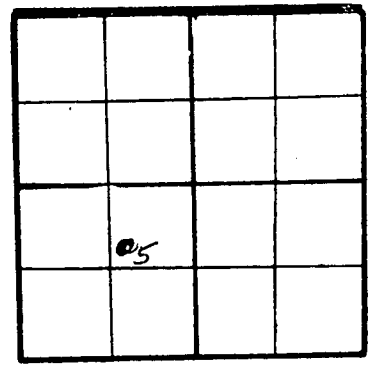

WELL PLAT
(Quarter) or (Full) Section - Please indicate.

KCC
KGS
MISC.


DRILLED WITH (CABLE) (ROTARY) (AIR) TOOLS
Report of all strings set - surface, intermediate, production, etc. (New)/(Used) casing.

Table with 8 columns: Purpose of string, Size hole drilled, Size casing set (in O.D.), Weight lbs/ft., Setting depth, Type cement, Sacks, Type and percent additives. Rows include Surface and Oil String.

Table with 6 columns: Liner Record (Top ft., Bottom ft., Sacks cement) and Perforation Record (Shots per ft., Size & type, Depth interval). Includes Tubing Record (Size, Setting depth, Packer set at).

Table with 2 columns: Amount and kind of material used, Depth interval treated. Row: 2000 gals. 15% Regular Acid., 3990-94 & 4032-36.

Table with 4 columns: TEST DATE (11-8 & 11-9), PRODUCTION (Date of first production, Producing method), A.P.I. Gravity (36), RATE OF PRODUCTION PER 24 HOURS (Rec. 35 BO on 4 hr. Swab test), Gas, Water, Gas-oil ratio, Disposition of gas (vented, used on lease or sold), Producing Interval (3990-96 & 4032-36).

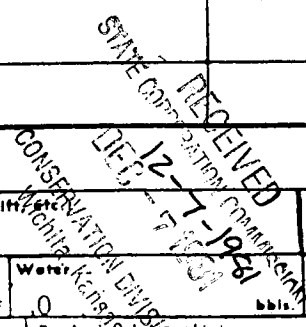

\*\* The person who can be reached by phone regarding any questions concerning this information.
A witnessed initial test by the Commission is required if the well produces more than 25 BOPD or is located in a Basic Order Pool.

Name of lowest fresh water producing stratum sand Depth 115'  
Estimated height of cement behind pipe circ. to surface

**WELL LOG**

Show all important zones of porosity and contents thereof; cored intervals, and all drill-stem tests, including depth interval tested, cushion used, time tool open, flowing and shut-in pressures, and recoveries.

SHOW GEOLOGICAL MARKERS, LOGS RUN, OR OTHER DESCRIPTIVE INFORMATION.

FORMATION DESCRIPTION, CONTENTS, ETC.	TOP	BOTTOM	NAME	DEPTH
Copy of geological report, drillers log, & Elec. log enclosed.,				

USE ADDITIONAL SHEETS, IF NECESSARY, TO COMPLETE WELL RECORD.

A F F I D A V I T

STATE OF Kansas, COUNTY OF Ellis SS,

Don E. Pratt OF LAWFUL AGE, BEING FIRST DULY SWORN UPON HIS OATH, DEPOSES AND SAYS:

THAT HE IS Operator FOR Don E. Pratt Oil Operations OPERATOR OF THE Denio LEASE, AND IS DULY AUTHORIZED TO MAKE THIS AFFIDAVIT FOR AND ON BEHALF OF SAID OPERATOR, THAT WELL NO. 5 ON SAID LEASE HAS BEEN COMPLETED AS OF THE 9th DAY OF November, 1981, AND THAT ALL INFORMATION ENTERED HEREIN WITH RESPECT TO SAID WELL IS TRUE AND CORRECT.

FURTHER AFFIANT SAITH NOT.

(S) Don E. Pratt Don E. Pratt

SUBSCRIBED AND SWORN TO BEFORE ME THIS 4th DAY OF December, 1981

Helen Ubert Helen Ubert  
NOTARY PUBLIC

MY COMMISSION EXPIRES: 7-22-85

