

TYPE

AFFIDAVIT OF COMPLETION FORM

ACO-1 WELL HISTORY

SIDE ONE

Two (2) copies of this form shall be filed with the Kansas Corporation Commission, 200 Colorado Derby Building, Wichita, Kansas 67202, within thirty (30) days after the completion of a well, regardless of how the well was completed.

Attach separate letter of request if the information is to be held confidential. If confidential, only file one copy. Information on Side One will be of public record and Side Two will then be held confidential.

Applications must be made on dual completion, commingling, salt water disposal, injection and temporarily abandoned wells.

Attach one copy only wireline logs (i.e. electrical log, sonic log, gamma ray neutron log, etc.). (Rules 82-2-105 & 82-2-125) KCC# (316) 263-3238.

LICENSE # 5285 EXPIRATION DATE June 30, 1983

OPERATOR The Dane G. Hansen Trust API NO. 15-065-21,761-0000

ADDRESS P. O. Box 187 COUNTY Graham

Logan, Kansas 67646 FIELD Conness Est.

** CONTACT PERSON Dane G. Bales PROD. FORMATION _____

PHONE 913-689-4816

PURCHASER None LEASE Conness

ADDRESS _____ WELL NO. 1

DRILLING Galloway Drilling Co., Inc. WELL LOCATION W/2 E/2 SE/4

CONTRACTOR 340 Broadway Plaza Building 1320ft. from South Line and

ADDRESS 105 S. Broadway 660ft. from West Line of

Wichita, Kansas 67202 the SE (Qtr.) SEC 22 TWP 10 RGE23w.

PLUGGING Allied Cementing

CONTRACTOR Box 31

ADDRESS Russell, Kansas 67665


TOTAL DEPTH 3837 PBTD _____

SPUD DATE 2/5/83 DATE COMPLETED 2/11/83

ELEV: GR 2311 DF 2313 KB 2316

DRILLED WITH (CABLE) (ROTARY) (AIR) TOOLS.

DOCKET NO. OF DISPOSAL OR REPRESSURING WELL BEING USED TO DISPOSE OF WATER FROM THIS LEASE _____

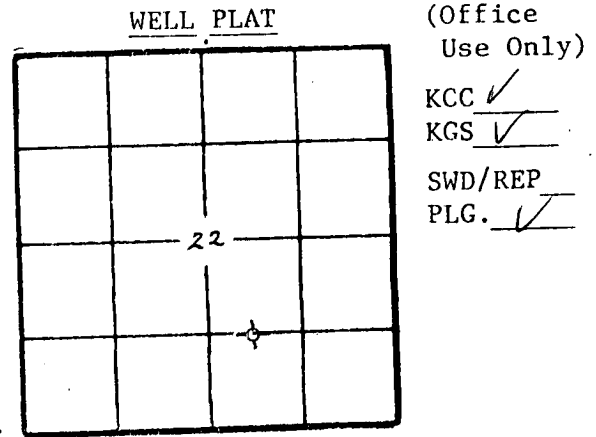

Amount of surface pipe set and cemented 243' DV Tool Used? No

THIS AFFIDAVIT APPLIES TO: (Circle ONE) - Oil, Gas, Shut-in Gas, Dry, Disposal, Injection, Temporarily Abandoned, OWWO. Other _____

ALL REQUIREMENTS OF THE STATUTES, RULES AND REGULATIONS PROMULGATED TO REGULATE THE OIL AND GAS INDUSTRY HAVE BEEN FULLY COMPLIED WITH.

A F F I D A V I T

Dane G. Bales, Manager, being of lawful age, hereby certifies that:

I am the Affiant, and I am familiar with the contents of the foregoing Affidavit. The statements and allegations contained therein are true and correct.


Dane G. Bales
(Name) Dane G. Bales

SUBSCRIBED AND SWORN TO BEFORE ME this 28th day of February, 1983.



Betty Jane Bittel
(NOTARY PUBLIC)
Betty Jane Bittel

MY COMMISSION EXPIRES: July 17, 1984

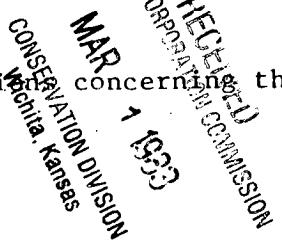

** The person who can be reached by phone regarding any questions concerning this information.

SIDE TWO

ACO-1 WELL HISTORY

OPERATOR Dane G. Hansen Trust LEASE Conness

SEC. 22 TWP. 10 RGE. 23w

FILL IN WELL LOG AS REQUIRED:

Show all important zones of porosity and contents thereof; cored intervals, and all drill-stem tests, including depth interval tested, cushion used, time tool open, flowing and shut-in pressures, and recoveries.

SHOW GEOLOGICAL MARKERS, LOGS RUN, OR OTHER DESCRIPTIVE INFORMATION.

FORMATION DESCRIPTION, CONTENTS, ETC.	TOP	BOTTOM	NAME	DEPTH
DST #1 - 3688-3712. 15-45-90-45. Rec. 190' Sl. oil spk mud. BHP's 214/155. FFP's 77-77/97-107 DST #2 - 3760-90. 15-45-90-45. Rec. 90' OCM. BHP's 379/301. FFP's 38-38/48-48. No Log Run D&A 2/11/83			Anhydrite	1857 (+459)
			Topeka	3344 (-1028)
			Heebner	3576 (-1260)
			Toronto	3598 (-1282)
			Lansing	3613 (-1297)
			BKC	3832 (-1516)
			RTD	3837

Report of all strings set — surface, intermediate, production, etc. CASING RECORD (New) or (Used)

Purpose of string	Size hole drilled	Size casing set (in O.D.)	Weight lbs/ft.	Setting depth	Type cement	Sacks	Type and percent additives
Surface	12 1/4"	8 5/8"	20#	243'	Common	180	3% CC; 2% Gel

LINER RECORD

PERFORATION RECORD

Top, ft.	Bottom, ft.	Sacks cement	Shots per ft.	Size & type	Depth interval

Size	Setting depth	Packer set at

ACID, FRACTURE, SHOT, CEMENT SQUEEZE RECORD

Amount and kind of material used	Depth interval treated

Date of first production	Producing method (flowing, pumping, gas lift, etc.)	Gravity
RATE OF PRODUCTION PER 24 HOURS	Oil bbls.	Gas MCF
	Water %	Gas-oil ratio bbls. CFPB
Disposition of gas (vented, used on lease or sold)		Perforations