

TYPE

AFFIDAVIT OF COMPLETION FORM

ACO-1 WELL HISTORY

Compt. _____

SIDE ONE

Two (2) copies of this form shall be filed with the Kansas Corporation Commission, 200 Colorado Derby Building, Wichita, Kansas 67202, within thirty (30) days after the completion of a well, regardless of how the well was completed.

F Attach separate letter of request if the information is to be held confidential. If confidential, only file one copy. Information on Side One will be of public record and Side Two will then be held confidential.

Applications must be made on dual completion, commingling, salt water disposal, injection and temporarily abandoned wells.

C Attach one copy only wireline logs (i.e. electrical log, sonic log, gamma ray neutron log, etc.). (Rules 82-2-105 & 82-2-125) KCC# (316) 263-3238.

LICENSE # 6114 EXPIRATION DATE 6-30-84

OPERATOR Don E. Pratt API NO. 15,-065-21,805-0000

ADDRESS P.O. Box 370 COUNTY Graham

Hays, KS 67601 FIELD (Connie Lou Disc)

** CONTACT PERSON Don E. Pratt PHONE 913-625-3446 PROD. FORMATION L, KC

PURCHASER Clear Creek, Inc., LEASE C. Griffith

ADDRESS 818 Century Plaza Bldg., WELL NO. 1-22

Wichita, KS 67202 WELL LOCATION 440' loc. C/N/2 NW

DRILLING Murfin Drilling Co., 440 Ft. from N Line and

CONTRACTOR 250 N. Water, Suite 300 1320 Ft. from W Line of

ADDRESS Wichita, KS 67202 the NW (Qtr.) SEC 22 TWP 10 RGE 23. W

PLUGGING Murfin Drilling Co.,

CONTRACTOR 250 N. Water

ADDRESS Wichita, KS 67202

TOTAL DEPTH 4060' PBDT

SPUD DATE 6-24-83 DATE COMPLETED 7-2-83

ELEV: GR 2376 DF 2379 KB 2381


DRILLED WITH (CABLE) (ROTARY) (AIR) TOOLS.

DOCKET NO. OF DISPOSAL OR REPRESSURING WELL BEING USED TO DISPOSE OF WATER FROM THIS LEASE

Amount of surface pipe set and cemented 175' DV Tool Used?

THIS AFFIDAVIT APPLIES TO: (Circle ONE) - Oil, Gas, Shut-in Gas, Dry, Disposal, Injection, Temporarily Abandoned, OWWO. Other

ALL REQUIREMENTS OF THE STATUTES, RULES AND REGULATIONS PROMULGATED TO REGULATE THE OIL AND GAS INDUSTRY HAVE BEEN FULLY COMPLIED WITH.

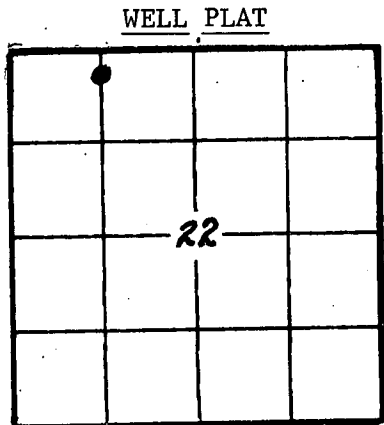

RECEIVED STATE CORPORATION COMMISSION AUG 19 1983 CONSERVATION DIVISION Wichita, Kansas


A F F I D A V I T

Don E. Pratt, being of lawful age, hereby certifies that:

I am the Affiant, and I am familiar with the contents of the foregoing Affidavit. The statements and allegations contained therein are true and correct.

(Signature of Don E. Pratt)
(Name) Don E. Pratt

SUBSCRIBED AND SWORN TO BEFORE ME this 18th day of August, 19 93.

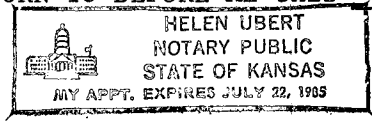

(Signature of Helen Ubert)
(NOTARY PUBLIC) Helen Ubert.,

MY COMMISSION EXPIRES: 7-22-85

** The person who can be reached by phone regarding any questions concerning this information.

