

CARD MUST BE TYPED



State of Kansas

CARD MUST BE SIGNED

NOTICE OF INTENTION TO DRILL

15-163-01152-0002

(see rules on reverse side)

Starting Date May 15, 1987 month day year

API Number 15-

OPERATOR: License # 6931
Name Bowman Oil Company
Address 101 Petroleum
City/State/Zip Codell, Kansas 67630
Contact Person Don Bowman
Phone 913-434-2304

SE NE NE Sec. 24 Twp. 10 S, Rg. 20
4290 Ft. from South Line of Section
330 Ft. from East Line of Section

(Note: Locate well on Section Plat on reverse side)

CONTRACTOR: License # 6997
Name Bill's Well Service
City/State Codell, Kansas 67630

Nearest lease or unit boundary line 330 feet
County Rooks
Lease Name Sutor "A" Well # 9

Well Drilled For: Well Class: Type Equipment:
Oil X SWD Infield X Mud Rotary
Gas Inj Pool Ext Air Rotary
X OWWO Expl Wildcat X Cable

Ground surface elevation 2218 feet MSL
Domestic well within 330 feet: yes X no
Municipal well within one mile: yes X no
Depth to bottom of fresh water 800'
Depth to bottom of usable water 950 800+

If OWWO: old well info as follows:

Operator Bowman Oil Company
Well Name Sutor "A" 9
Comp Date 10/10/80 Old Total Depth 3773

Morris Sitar
by Computer
oil in 7/82

Surface pipe by Alternate: 1 2 X
Surface pipe pl... be set 192
Conductor pipe required 192 (owwo) 3771
Projected Total Depth 3950'
Formation Granite Wash

I certify that well will comply with K.S.A. 55-101, et seq., plus eventually plugging hole to KCC specifications.

Date May 13, 1987 Signature of Operator or Agent Title Partner

For KCC Use:

Conductor Pipe Required feet; Minimum Surface Pipe Required 192 feet per Alt.
This Authorization Expires 11-13-87 Approved By 5-13-87


Handwritten signature and initials

Must be filed with the K.C.C. five (5) days prior to commencing well  
This card void if drilling not started within six (6) months of date received by K.C.C.

**Important procedures to follow:**

1. Notify District office before setting surface casing.
2. Set surface casing by circulating cement to the top.
3. File completion forms ACO-1 with K.C.C. within 90 days of well completion, following instructions on ACO-1, side 1, and including copies of wireline logs.
4. Notify District office 48 hours prior to old well workover or re-entry.
5. Prior to filing Intent, prepare a proposed plugging plan in case well is D & A, then obtain approval of plan when calling district office prior to setting surface pipe.
6. Submit plugging report (CP-4) to K.C.C. after plugging is completed.
7. Obtain an approved injection docket number before disposing of salt water.
8. Notify K.C.C. within 10 days when injection commences or terminates.
9. If an alternate 2 completion, cement in the production pipe from below any usable water to surface within 120 days of spud date.

**A Regular Section of Land  
1 Mile = 5,280 Ft.**

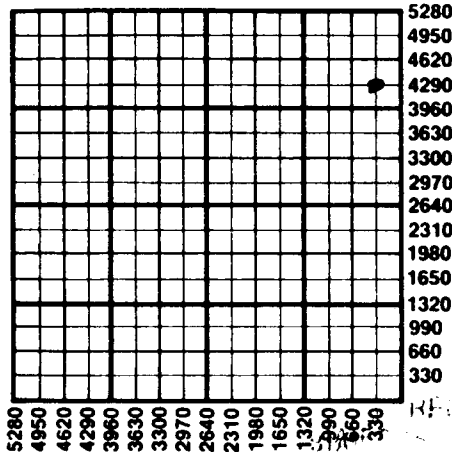

MAY 13 1987

Conservation Division  
Wichita, Kansas

State Corporation Commission of Kansas  
Conservation Division  
200 Colorado Derby Building  
Wichita, Kansas 67202  
(316) 263-3238