

STATE OF KANSAS  
STATE CORPORATION COMMISSION


RCUD  
07-27-81

WELL PLUGGING RECORD

Give All Information Completely  
Make Required Affidavit  
Mail or Deliver Report to  
Conservation Division  
State Corporation Comm.  
245 North Water  
Wichita, KS 67202

Graham County. Sec. 19 Twp. 10 Rge. 24 E/W  
Location as "NE/CNW $\frac{1}{4}$ SW $\frac{1}{4}$ " or footage from lines \_\_\_\_\_  
SW NE SW

Lease Owner Helberg Oil Company  
Lease Name Hobbs Well No. 1  
Office Address Box 32 Morland, Kansas 67650  
Character of Well (Completed as Oil, Gas or Dry Hole) \_\_\_\_\_

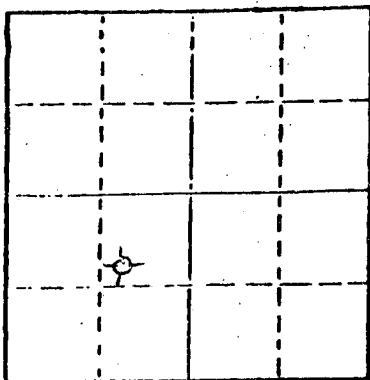

Locate well correctly on above  
Section Plat

Dry Hole  
Date Well completed July 19 19 81  
Application for plugging filed July 19 19 81  
Application for plugging approved July 19 19 81  
Plugging commenced July 19 19 81  
Plugging completed July 19 19 81  
Reason for abandonment of well or producing formation \_\_\_\_\_  
Dry Hole

If a producing well is abandoned, date of last production \_\_\_\_\_ 19 \_\_\_\_\_

Was permission obtained from the Conservation Division or its agents before plugging was commenced? Yes

Name of Conservation Agent who supervised plugging of this well Gilbert Balthazor  
Producing formation \_\_\_\_\_ Depth to top \_\_\_\_\_ Bottom \_\_\_\_\_ Total Depth of Well 3991  
Show depth and thickness of all water, oil and gas formations.

OIL, GAS OR WATER RECORDS

CASING RECORD

FORMATION	CONTENT	FROM	TO	SIZE	PUT IN	PULLED OUT
Surface		0	215'	8 5/8"	215'	0

Describe in detail the manner in which the well was plugged, indicating where the mud fluid was placed and the method or methods used in introducing it into the hold. If cement or other plugs were used, state the character of same and depth placed, from \_\_\_\_\_ feet to \_\_\_\_\_ feet for each plug set.

1st Plug set at 1050' with 60 sacks common cement 50-50 poz 6% Gel

2nd. Plug set at 230' with 30 sacks common cement 50-50 poz 6% Gel

3rd. Plug set at 40' with 10 sacks common cement 50-50 poz 6% Gel

5 sacks in rat hole

Heavy drilling mud between plugs.

(If additional description is necessary, use BACK of this sheet)

Name of Plugging Contractor Sun Oilwell Cementing

STATE OF Kansas COUNTY OF Graham, ss.  
Jerry M. Helberg (employee of owner) or (owner or operator)  
of the above-described well, being first duly sworn on oath, says: That I have knowledge of the facts, statements, and matters herein contained and the log of the above-described well as filed and that the same are true and correct. So help me God.

(Signature)

Box 32 Morland, Kansas 67650  
(Address)

SUBSCRIBED AND SWORN TO before me this \_\_\_\_\_ day of Aug, 1981

Faye E. Minium  
Notary Public.

My commission expires \_\_\_\_\_



DRILLERS LOG

HOBBS #1

CASING RECORD:

8 5/8" set at 215'

TOTAL DEPTH:

3961'

DESCRIPTION:

SW NE SW

Sec. 19, Twp.10, Rng. 24

OPERATOR: Helberg Oil Company

CONTRACTOR: Helberg Oil Company

COMMENCED: July 9, 1981

COMPLETED: July 19, 1981

FORMATION	FROM	TO	REMARKS
Sand	0	220	
Sand	220	950	
Sand & Shale	950	1515	
Sand & Shale	1515	1894	
Shale	1894	2114	
Anhydrite	2114	2124	
Anhydrite	2124	2147	
Shale	2147	2217	
Shale	2217	2400	
Shale	2400	2579	
Shale	2579	2765	
Shale	2765	2897	
Shale & Lime	2897	3022	
Shale & Lime	3022	3177	
Shale & Lime	3177	3275	
Shale & Lime	3275	3368	
Shale & Lime	3368	3472	
Shale & Lime	3472	3539	
Shale & Lime	3539	3612	
Shale & Lime	3612	3697	
Shale & Lime	3697	3740	
Lime	3740	3795	
Lime 27 1/2	3795	3804	
Lime	3804	3857	
Lime	3857	3913	
Lime	3913	3956	
Lime	3956	3961	
T.D.	3961		D&A

I certify that the above is a true and correct copy of the log to the best of my knowledge.

Helberg Oil Company

*Jerry M. Helberg*  
 \_\_\_\_\_  
 Jerry M. Helberg

Subscribed and sworn to before me this 5 day of Aug, 1981.

*Alene E. Morrison*  
 \_\_\_\_\_  
 Notary Public

My commission expires \_\_\_\_\_

