

NOTICE OF INTENTION TO DRILL

(see rules on reverse side)

"CORRECTED INTENT"

Expected Spud Date. 4-1-88 month day year

API Number 15- 065-22, 448 - 0000

OPERATOR: License # 6861
Name Ron's Oil Operations, Inc.
Address P. O. Box 112
City/State/Zip Penokee, Kansas 67659
Contact Person Ronald Nickelson
Phone (913)-674-2409

NE East
SE SE Sec. 30. Twp. 10 S, Rg. 24 West
805 Ft. from South Line of Section
1280 Ft. from East Line of Section

(Note: Locate well on Section Plat on reverse side)

CONTRACTOR: License # 8241
Name Emphasis Oil Operations
City/State Russell, KS 67665

Nearest lease or unit boundary line 805 feet
County Graham

Well Drilled For: Well Class: Type Equipment:
X Oil Storage X Infield X Mud Rotary
Gas Inj Pool Ext Air Rotary
OWWO Expl Wildcat Cable

Lease Name Gano Well # 2
Ground surface elevation 2475 feet MSL
Domestic well within 330 feet: yes X no
Municipal well within one mile: yes X no
Depth to bottom of fresh water 200
Depth to bottom of usable water 200
Surface pipe by Alternate: 1 2 X

If OWWO: old well info as follows:
Operator
Well Name
Comp Date Old Total Depth

Surface pipe planned to be set 250
Conductor pipe required N/A
Projected Total Depth 4100 feet
Formation Lansing-KC

I certify that well will comply with K.S.A. 55-101, et seq., plus eventually plugging hole to KCC specifications.
Date 4-5-88 Signature of Operator or Agent Kyle B. Branum Title President


For KCC Use:
Conductor Pipe Required feet; Minimum Surface Pipe Required 220 feet per Alt.
This Authorization Expires 9-29-88 Approved By RCH 7-6-88 ORLG RCV'D 3-29-88

*WAS: NE-SE-SE 360' FEL N.L.L 360'

Must be filed with the K.C.C. five (5) days prior to commencing well
 This card void if drilling not started within six (6) months of date received by K.C.C.

Important procedures to follow:

**A Regular Section of Land
 1 Mile = 5,280 Ft.**

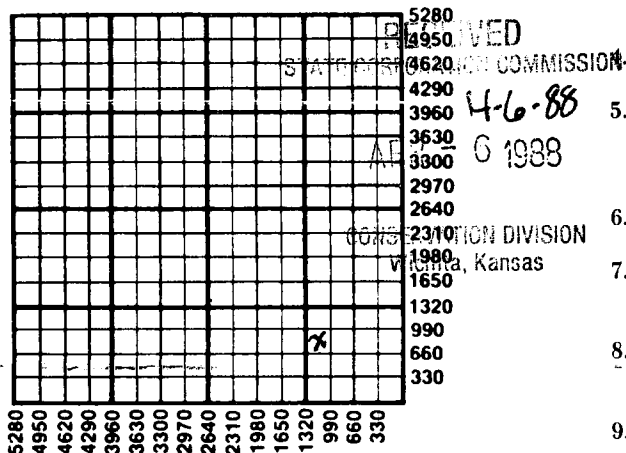

1. Notify District office before setting surface casing.
2. Set surface casing by circulating cement to the top.
3. File completion forms ACO-1 with K.C.C. within 120 days of well spud date, following instructions on ACO-1, side 1, and including copies of wireline logs.
4. Notify District office 48 hours prior to old well workover or re-entry.
5. Prior to filing Intent, prepare a proposed plugging plan in case well is D & A, then obtain approval of plan when calling district office prior to setting surface pipe.
6. Submit plugging report (CP-4) to K.C.C. after plugging is completed.
7. Obtain an approved injection docket number before disposing of salt water.
8. Notify K.C.C. within 10 days when injection commences or terminates.
9. If an alternate 2 completion, cement in the production pipe from below any usable water to surface within 120 days of spud date.

State Corporation Commission of Kansas
 Conservation Division
 200 Colorado Derby Building
 Wichita, Kansas 67202-1212
 (316) 263-3238