

STATE OF KANSAS  
STATE CORPORATION COMMISSION

Form CP-4

WELL PLUGGING RECORD

Give All Information Completely  
Make Required Affidavit  
Mail or Deliver Report to:  
Conservation Division  
State Corporation Commission  
212 No. Market  
Wichita, Kansas

Marion County, Sec. 23 Twp. 17 Rge. 4 (E) (W)

Location as "NE/CNW/SW" or footage from lines C E/2 E/2 NE/4

Lease Owner John W. Gehrke

Lease Name Sweeney Well No. 6

Office Address Herington, Kansas

Character of Well (completed as Oil, Gas or Dry Hole) Dry Hole

Date well completed 2-22, 1967

Application for plugging filed 2-22, 1967

Application for plugging approved 2-22, 1967

Plugging commenced 2-22, 1967

Reason for abandonment of well or producing formation 2-22, 1967

Reason for abandonment of well or producing formation

Reason for abandonment of well or producing formation


If a producing well is abandoned, date of last production 19

Was permission obtained from the Conservation Division or its agents before plugging was commenced? Yes

Name of Conservation Agent who supervised plugging of this well Hugh Scott

Producing formation Depth to top Bottom Total Depth of Well 2352 Feet

Show depth and thickness of all water, oil and gas formations.

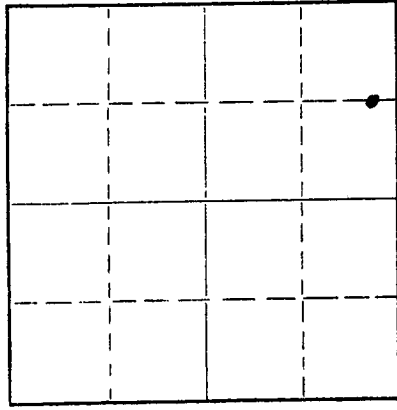

Locate well correctly on above Section Plat

OIL, GAS OR WATER RECORDS

CASING RECORD

FORMATION	CONTENT	FROM	TO	SIZE	PUT IN	PULLED OUT
				8 5/8	205	None

Describe in detail the manner in which the well was plugged, indicating where the mud fluid was placed and the method or methods used in introducing it into the hole. If cement or other plugs were used, state the character of same and depth placed, from feet to feet for each plug set.

Filled hole with mud to 200'

Set plug on mud

Dumped 25 sacks of cement on plug

Filled with mud to 45'

Set plug on mud

Filled to surface with cement

Plugging completed.

RECEIVED  
FEB 27 1967  
02-27-67

(If additional description is necessary, use BACK of this sheet)

Name of Plugging Contractor Slusser Drilling Company

Address Box 275, Marion, Kansas 66861

STATE OF Kansas, COUNTY OF Marion, ss.  
Billy H. Slusser (employee of owner) or (owner or operator) of the above-described

well, being first duly sworn on oath, says: That I have knowledge of the facts, statements, and matters herein contained and the log of the above-described well as filed and that the same are true and correct. So help me God.

(Signature) Billy H. Slusser

Box 275, Marion, Kansas 66861 (Address)

SUBSCRIBED AND SWORN to before me this 23rd. day of February, 1967

My commission expires July 6, 1967

(Mrs.) Vivian I. Mott Conyers Notary Public.

DRILLERS LOG

Company  
Contractor  
Farm  
8 5/8

John W. Gehrke  
Slusser Drilling Co.  
Sweeney #6  
@ 205

Commenced 2-18-67  
Completed 2-22-67  
C E/2 E/2 NE/4 23-17-4  
Marion Co., Kansas

Surface Soil	5
Shale & Shells	90
Lime & Shale	500
Shale & Shells	1230
Shale & Lime	1590
Sand	1675
Shale & Lime	1685
Shale	1725
Sand	1755
Shale	1768
Lime	2090
Lime & Shale	2185
Lime	2304
Chat	2350
Lime	2352 Rotary T. D.

RECEIVED  
STATE CONSERVATION COMMISSION

FEB 27 1967

CONSERVATION DIVISION  
Wichita, Kansas