

WELL PLUGGING RECORD

Give All Information Completely
Make Required Affidavit
Mail or Deliver Report to
Conservation Division
State Corporation Comm.
200 Colorado Derby Bldg.
202 W. 1st St.
Wichita, KS 67202


Graham County Sec. 5 Twp. 10s Rge. 25 E/W
Location as "NE/CNW/SW" or footage from lines _____
SE NW SE

Lease Owner Herman Fellhoelter, Jr.
Lease Name Brungardt (OWWO) Well No. #1
Office Address P.O. Box 86 509 S.Wyoming Plainville,
Character of Well (Completed as Oil, Gas or Dry Hole) Ks 67663
Dry Hole (OWWO)

Date Well completed February 21 1982
Application for plugging filed February 21 1982
Application for plugging approved February 21 1982
Plugging commenced February 21 1982
Plugging completed 10:00 P.M. February 21 1982
Reason for abandonment of well or producing formation No Commercial Production

If a producing well is abandoned, date of last production _____ 19____

Was permission obtained from the Conservation Division or its agents before plugging was commenced? Yes

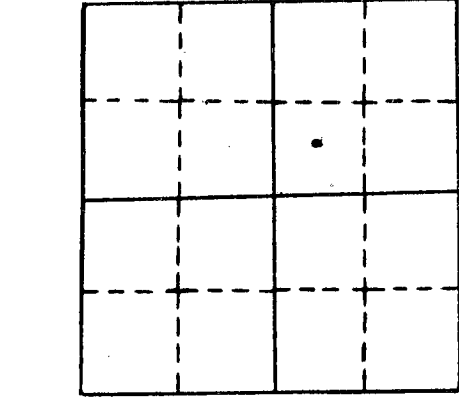

locate well correctly
on above
Section Plot

Name of Conservation Agent who supervised plugging of this well Gil Balthazor
Producing formation _____ Depth to top _____ Bottom _____ Tl. Depth of Well _____
Show depth and thickness of all water, oil and gas formations.

OIL, GAS OR WATER RECORDS

CASING RECORD

FORMATION	CONTENT	FROM	TO	SIZE	PUT IN	PULLED OUT
Surface Casing	8 5/8"	0	311'	8 5/8		

Describe in detail the manner in which the well was plugged, indicating where the mud fluid was placed and the method or methods used in introducing it into the hold. If cement or other plugs were used, state the character of same and depth placed, from _____ feet to _____ feet for each plug set.

Plug #1 1200' with 70sxs

Plug #2 300' with 40sxs

Plug #3 40' with 10sxs

10sxs in rathole

Total----130sxs

P.D. @ 12:00 P.M. 2-21-82

RECEIVED
STATE CORPORATION COMMISSION

MAR 23 1982

CONSERVATION DIVISION
Wichita, Kansas

(If additional description is necessary, use BACK of this sheet)

Name of Plugging Contractor Pioneer Drilling Company
308 West Mill Plainville, Ks 67663

STATE OF Kansas COUNTY OF Rooks, ss.

Herman Fellhoelter, Jr. (employee of owner) or (owner or operator) of the above described well, being first duly sworn on oath, says: That I have knowledge of the facts, statements, and matters herein contained and the log of the above described well is filed and that the same are true and correct. So help me God.

(Signature) Herman Fellhoelter, Jr.

(Address) P. O. Box 86 - Plainville, Kansas 67663

SUBSCRIBED AND SWORN TO before me this 5th day of March, 19 82

Irene Fellhoelter
State Notary Public

Rooks County, Kansas

My commission expires

My Commission Expires 4-4-83

Irene Fellhoelter
Notary Public