

STATE OF KANSAS  
STATE CORPORATION COMMISSION  
Give All Information Completely  
Make Required Affidavit  
Mail or Deliver Report to:  
Conservation Division  
State Corporation Commission  
212 North Market, Insurance Bldg.  
Wichita, Kansas

WELL PLUGGING RECORD

Graham County. Sec. 5 Twp. 10S Rge. 25W (E) (W)

Location as "NE/CNW/SW" or footage from lines NW/NW/SW

Lease Owner John O. Farmer, Inc.

Lease Name Pfeifer Well No. #1

Office Address Russell, Kansas

Character of Well (completed as Oil, Gas or Dry Hole) \_\_\_\_\_

Date well completed \_\_\_\_\_ 19 \_\_\_\_\_

Application for plugging filed Yes 19 \_\_\_\_\_

Application for plugging approved Yes 19 \_\_\_\_\_

Plugging commenced \_\_\_\_\_ 8-9 19 59

Plugging completed \_\_\_\_\_ 8-13 19 59

Reason for abandonment of well or producing formation \_\_\_\_\_


If a producing well is abandoned, date of last production \_\_\_\_\_ 19 \_\_\_\_\_

Was permission obtained from the Conservation Division or its agents before plugging was commenced? Yes

Name of Conservation Agent who supervised plugging of this well Mr. Fabricius

Producing formation \_\_\_\_\_ Depth to top \_\_\_\_\_ Bottom \_\_\_\_\_ Total Depth of Well 4295' Feet

Show depth and thickness of all water, oil and gas formations.

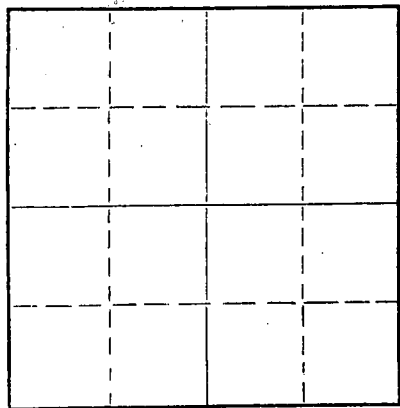

Locate well correctly on above Section Plat

OIL, GAS OR WATER RECORDS

CASING RECORD

FORMATION	CONTENT	FROM	TO	SIZE	PUT IN	PULLED OUT
				8 5/8"	surface	
				5 1/2"	casing	1,862'

Describe in detail the manner in which the well was plugged, indicating where the mud fluid was placed and the method or methods used in introducing it into the hole. If cement or other plugs were used, state the character of same and depth placed, from \_\_\_\_\_ feet to \_\_\_\_\_ feet for each plug set.

Measured into T.D. 4295'.  
Plugging started 8-9-59. Finished 8-13-59.  
Plugged off bottom and pushed plug to 3860'. Dumped 3 sacks of cement. Worked and shot pipe. Shot 5 1/2" casing at 1,862'.  
Pulled pipe out of hole and plugged well as follows: Mudded to 164'. Set rock bridge and dumped 25 sacks of cement. Filled hole with mud to 40'. Set rock bridge and mixed 10 sacks of cement for cap on well. Well completed.


RECEIVED  
STATE CORPORATION COMMISSION  
AUG 20 1959  
CONSERVATION DIVISION  
Wichita, Kansas

Name of Plugging Contractor J.O. Forbes d/b/a Forbes Casing Pulling Co.  
Address Box 221, Great Bend, Kansas

STATE OF Kansas, COUNTY OF Barton, ss.  
J.O. Forbes (employee of owner) or (owner or operator) of the above-described well, being first duly sworn on oath, says: That I have knowledge of the facts, statements, and matters herein contained and the log of the above-described well as filed and that the same are true and correct. So help me God.

(Signature) J.O. Forbes  
Box 221, Great Bend, Kansas  
(Address)

SUBSCRIBED AND SWORN to before me this 18th day of August, 1959  
Betty S. Edman  
Notary Public.

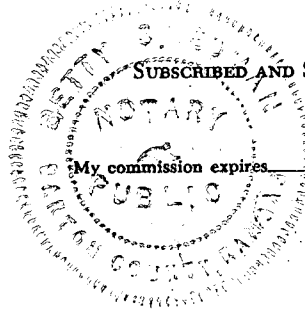


PLUGGING  
FILE SEC. 5 T. 10 R. 25W  
BOOK PAGE 58 LINE 2

OPERATOR JOHN O. FARMER, INC.

ADDRESS Russell, Kansas

Give detailed description and thickness of all formation drilled through, contents of sand, whether dry, water, oil or gas.

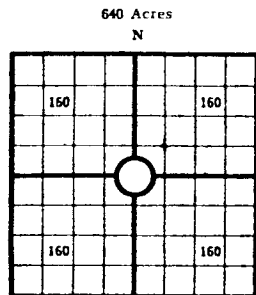

COUNTY Graham, SEC. 5, TWP. 10S, RGE. 25W  
 COMPANY OPERATING JOHN O. FARMER, INC.  
 OFFICE ADDRESS Russell, Kansas  
 DRILLING STARTED 5/4, 19 59 DRILLING FINISHED 5/16 19 59  
 DATE OF FIRST PRODUCTION \_\_\_\_\_ COMPLETED \_\_\_\_\_  
 WELL LOCATED NW 1/4 NW 1/4 SW 1/4, North of South  
 Line and \_\_\_\_\_ ft. East of West Line of Quarter Section  
 Elevation (Relative to sea level) DERRICK FLOOR 2575 GROUND, 2572  
 CHARACTER OF WELL (Oil, gas or dryhole) Oil

OIL OR GAS SANDS OR ZONES

Name	From	To	Name	From	To
1			4		
2			5		
3			6		

Perforating Record If Any

Shot Record

Formation	From	To	No. of Shots	Formation	From	To	Size of Shot

CASING RECORD

Amount Set						Amount Pulled		Packer Record	
Size	Wt.	Thds.	Make	Ft.	In.	Size	Length	Depth Set	Make
8-5/8				165					

Liner Record: Amount \_\_\_\_\_ Kind \_\_\_\_\_ Top \_\_\_\_\_ Bottom \_\_\_\_\_

CEMENTING AND MUDDING

Size	Amount Set		Sacks Cement	Chemical		Method of Cementing	Amount	Mudding Method	Results (See Note)
	Ft.	In.		Gal.	Make				
5/8	165		120						
5-1/2	4070		110						

Note: What method was used to protect sands if outer strings were pulled? \_\_\_\_\_

NOTE: Were bottom hole plugs used? \_\_\_\_\_ If so, state kind, depth set and results obtained \_\_\_\_\_

TOOLS USED

Rotary Tools were used from \_\_\_\_\_ feet to \_\_\_\_\_ Cable tools were used from \_\_\_\_\_ feet to \_\_\_\_\_ feet, and from \_\_\_\_\_ feet to \_\_\_\_\_ feet, and from \_\_\_\_\_ feet to \_\_\_\_\_ feet to \_\_\_\_\_

Type Rig \_\_\_\_\_

INITIAL PRODUCTION TEST

Describe initial test: whether by flow through tubing or casing or by pumping \_\_\_\_\_

Amount of Oil Production \_\_\_\_\_ bbls. Size of choke, if any \_\_\_\_\_ Length of test \_\_\_\_\_ Water

Production \_\_\_\_\_ bbls. Gravity of oil \_\_\_\_\_ Type of Pump if pump is used, describe \_\_\_\_\_

Formation	Top	Bottom	Formation	Top	Bottom
FARM NAME. . . . . PFEIFER #1					
Shale & sand	0	164			
Shale	164	420			
Shale & sand	420	1250			
Shale & shells	1250	1695			
Shale	1695	1795			
Sand	1795	1965	ELEVATION:	RB	2577
Redbed	1965	2184			
Anhydrite	2184	2233			
Shale & shells	2233	2255			
Shale & shells	2255	2650	TOPS:	sample	log
Shale & lime	2650	2820			
Lime & shale	2820	3900	Anhydrite	2185	
Lime	3900	3945	Heebner	3796	3796
Lime & shale	3945	4135	Toronto	3815	3818
Shale & lime	4135	4235	M Lansing	3825	3826
Lime & shale	4235	4295	B/KC		4072
T.D.		4295	Cherokee shale		4276
			Cherokee lime	4283	4284
			T.D.	4295	4295
			5-1/2" pipe set at		4070
			w/ 110 sacks cement.		

I, the undersigned, being first duly sworn upon oath, state that this well record is true, correct and complete according to the records of this office and to the best of my knowledge and belief.

*John O. Farmer, Inc.*  
Name and title of representative of company

Subscribed and sworn to before me this 18th day of May, 19 59

My Commission expires 10/11/62  
*Justice*  
Notary Public

PLUGGING  
FILE SEC 5 T 10 R 25  
BOOK PAGE 58 LINE 2

15-005-00811-0000  
SEC. 5 TWP. 10S RGE. 25W  
COUNTY Graham  
WELL NO. 1  
PFEIFER  
FARM NAME