


15-065-0115-0000

WELL PLUGGING RECORD

Give All Information Completely
Make Required Affidavit
Mail or Deliver Report to:
Conservation Division
State Corporation Commission
212 North Market, Insurance Bldg.
Wichita, Kansas

NORTH

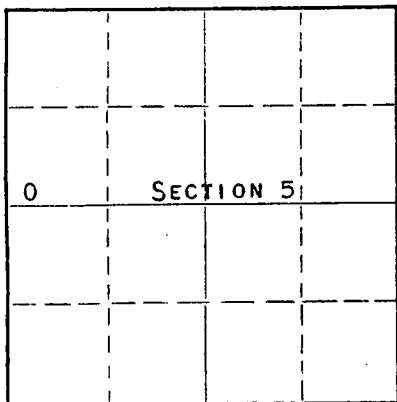

Locate well correctly on above Section Plat

GRAHAM County. Sec. 5 Twp. 10S Rge. 25W (W)

Location as "NE/CNW/SW" or footage from lines APPROX. SW SW NW
Lease Owner PETROLEUM, INC.
Lease Name VANCE "D" Well No. 1
Office Address ROUTE 2, GREAT BEND, KANSAS
Character of Well (completed as Oil, Gas or Dry Hole) DRY HOLE
Date well completed NOVEMBER 1 19 59
Application for plugging filed NOVEMBER 1 19 59
Application for plugging approved NOVEMBER 1 19 59
Plugging commenced NOVEMBER 1 19 59
Plugging completed NOVEMBER 1 19 59
Reason for abandonment of well or producing formation NO PRODUCIBLE ZONES

If a producing well is abandoned, date of last production NONE 19
Was permission obtained from the Conservation Division or its agents before plugging was commenced? YES

Name of Conservation Agent who supervised plugging of this well A. D. FABRICIUS, BOX 731, HILL CITY, KANSAS
Producing formation --- Depth to top --- Bottom --- Total Depth of Well 4088 Feet
Show depth and thickness of all water, oil and gas formations.

OIL, GAS OR WATER RECORDS

CASING RECORD

FORMATION	CONTENT	FROM	TO	SIZE	PUT IN	PULLED OUT
				8-5/8"	180'	NONE

Describe in detail the manner in which the well was plugged, indicating where the mud fluid was placed and the method or methods used in introducing it into the hole. If cement or other plugs were used, state the character of same and depth placed, from ___ feet to ___ feet for each plug set.

MUD UP WITH HEAVY MUD TO 500' FOLLOWED BY A WOODEN PLUG. PLACED 20 SACKS OF CEMENT THROUGH DRILL PIPE ON TOP OF PLUG. MUD UP TO 180' FOLLOWED BY A WOODEN PLUG. PLACED 20 SACKS OF CEMENT THROUGH DRILL PIPE ON TOP OF PLUG. MUD UP TO 40' FOLLOWED BY A WOODEN PLUG. FILLED HOLE TO BASE OF WELL CELLAR WITH 10 SACKS OF CEMENT.

RECEIVED
STATE CORPORATION COMMISSION

NOV 24 1959

CONSERVATION DIVISION
Wichita, Kansas

(If additional description is necessary, use BACK of this sheet)

Name of Plugging Contractor GARVEY DRILLING COMPANY
Address ROUTE 2, GREAT BEND, KANSAS

STATE OF KANSAS, COUNTY OF BARTON, ss.
DON SEARLE (employee of owner) or () of the above-described well, being first duly sworn on oath, says: That I have knowledge of the facts, statements, and matters herein contained and the log of the above-described well as filed and that the same are true and correct. So help me God.

(Signature) Don Searle
ROUTE 2, GREAT BEND, KANSAS
(Address)

SUBSCRIBED AND SWORN TO before me this 20TH day of NOVEMBER, 1959

My commission expires APRIL 14, 1963

Arthur J. Miles
Notary Public.



WELL LOG 15-005-0117-0000

COMPANY PETROLEUM, INCORPORATED

SEC. 5 T. 10S R. 25W

FARM VANCE "D" NO. 1


LOC. App. SW, SW, NW

TOTAL DEPTH 4088'

COUNTY GRAHAM CO., KANSAS

COMM. October 22, 1959 COMP. November 1, 1959

CONTRACTOR GARVEY DRILLING COMPANY

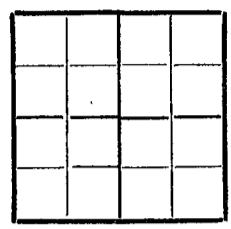

CASING 8 5/8" @ 180' W/125 sax.

ELEVATION 2579' GL

PRODUCTION D & A

FIGURES INDICATE BOTTOM OF FORMATIONS

180	Surface clay & shale
915	Shale
1180	Shale & shells
1370	Sand
1680	Shale
1655	Shale & shells
1688	Anhydrite
2610	Shale & red bed
2840	Shale & lime
3105	Lime & shale
3220	Shale
3635	Shale & lime
3850	Lime & shale
4010	Lime
4088	Lime & shale
4088	T. D.

RECEIVED
 STATE CORPORATION COMMISSION
 NOV 24 1959
 CONSERVATION DIVISION
 Wichita, Kansas

State of KANSAS }
 County of BARTON } ss:

I, VERNE A. MORRIS of GARVEY DRILLING COMPANY

upon oath state that the above and foregoing is a true and correct copy of the log of the #1 VANCE "D" well.

Verne A. Morris

Subscribed and sworn to before me this 14th day of November 19 59

My Commission Expires April 14, 1963

Arthur J. Gible
 NOTARY PUBLIC

