


STATE OF KANSAS
STATE CORPORATION COMMISSION

Give All Information Completely
Make Required Affidavit
Mail or Deliver Report to:
Conservation Division
State Corporation Commission
211 No. Broadway
Wichita, Kansas

15-065-02085-0000
WELL PLUGGING RECORD

NORTH

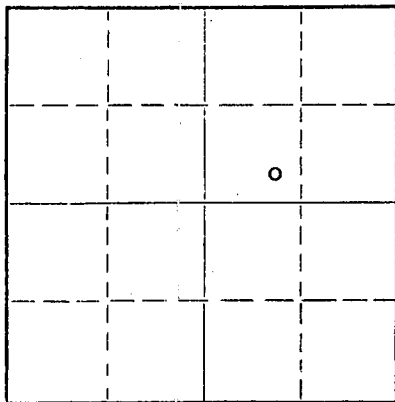

Locate well correctly on above
Section Flat

Graham County. Sec. 5 Twp. 10 S Rge. (E) 25 (W)
Location as "NE/CNW&SW&" or footage from lines SE SW NE
Lease Owner Kimbark Exploration Company
Lease Name Vance Well No. 2
Office Address 201 Univ. Blvd. - Denver 6, Colo.
Character of Well (completed as Oil, Gas or Dry Hole) Dry Hole
Date well completed 8/25/62 19
Application for plugging filed 8/25/62 19
Application for plugging approved 8/25/62 19
Plugging commenced 8/25/62 19
Plugging completed 8/25/62 19
Reason for abandonment of well or producing formation _____

If a producing well is abandoned, date of last production _____ 19
Was permission obtained from the Conservation Division or its agents before plugging was commenced? Yes

Name of Conservation Agent who supervised plugging of this well Eldon Pettey
Producing formation _____ Depth to top _____ Bottom _____ Total Depth of Well 4076 Feet
Show depth and thickness of all water, oil and gas formations.

OIL, GAS OR WATER RECORDS

CASING RECORD

FORMATION	CONTENT	FROM	TO	SIZE	PUT IN	PULLED OUT
		Surf.	196'	8 5/8"	150 sxs	0

Describe in detail the manner in which the well was plugged, indicating where the mud fluid was placed and the method or methods used in introducing it into the hole. If cement or other plugs were used, state the character of same and depth placed, from _____ feet to _____ feet for each plug set.

550-180 - 20 sxs
180- 35 - 20 sxs
35-0 - 10 sxs


RECEIVED
STATE CORPORATION COMMISSION
SEP 4 1962
9-4-62
CONSERVATION DIVISION
Wichita, Kansas

(If additional description is necessary, use BACK of this sheet)
Name of Plugging Contractor Kimbark Exploration Company
Address 201 Univ. Blvd. - Denver 6, Colo.

STATE OF Colorado, COUNTY OF Denver, ss.
W. K. Arbuckle (employee of owner) or (owner or operator) of the above-described well, being first duly sworn on oath, says: That I have knowledge of the facts, statements, and matters herein contained and the log of the above-described well as filed and that the same are true and correct. So help me God.

(Signature) W. K. Arbuckle
201 Univ. Blvd. - Denver 6, Colo.
(Address)

SUBSCRIBED AND SWORN to before me this 31st day of August, 19 62
My commission expires November 15, 1964
Walter G. Kohn Notary Public.

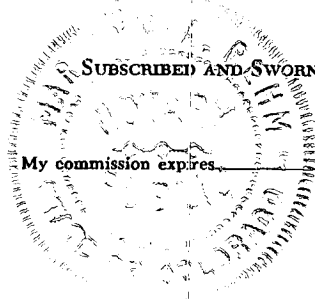

15-065-02085-0000

VANCE #2 WELL

Location: SE SW NE Section 5
T-10-S, R-25-W
Graham County, Kansas

Spudded: 8/15/62
Completed: 8/25/62

Owner: Kimbark Exploration Company
201 University Blvd.
Denver 6, Colorado

Contractor: Kimbark Expl. Co.
201 University Blvd.
Denver 6, Colorado

Surface Casing: 8 5/8" ss casing cemented at 196' K.B. with 150 sacks quick set.

Oil String: None

LOG

Figures indicate bottom of formation

198	Shale
1,437	Shale-Sand
1,635	Shale
2,500	Shale-Shells
2,660	Shale-Lime
2,740	Shale-Lime-Pyrite
3,080	Lime
3,360	Lime
3,595	Lime
3,803	Lime
3,938	Lime
4,027	Lime
4,075	Lime
4,075	Rotary Total Depth

RECEIVED
COMMISSION
SEP 4 1962
CONSERVATION DIVISION
Wichita, Kansas

The undersigned, W. K. Arbuckle, President of Kimbark Exploration Company, hereby certifies that the above is a true and correct log of the formations encountered in drilling the Vance #2 as shown in the daily drilling reports.

KIMBARK EXPLORATION COMPANY

W. K. Arbuckle

W. K. Arbuckle, President

STATE OF COLORADO) ss.
CITY & COUNTY OF DENVER)

Be it remembered that on this 31st day of August A.D. 1962, before me, Marilyn A. Rehm, a Notary Public, personally appeared W. K. Arbuckle, President of Kimbark Exploration Company, a Colorado Corporation, who is personally known to me and known to me to be the President of said Corporation, and the same person who executed the foregoing instrument, and he duly acknowledged the execution of the same for and on behalf of and as the act and deed of said Corporation.

WITNESS my hand and official seal:
My commission expires November 15, 1964

Marilyn A. Rehm
Notary Public