


Give All Information Completely
No Required Affidavit
Mail or Deliver Report to:
Conservation Division
State Corporation Commission
800 Biting Building
Wichita, Kansas

WELL PLUGGING RECORD

GRAHAM County. Sec. 8 Twp. 10 Rge. 25 (E) (W)
Location as "NE/CNW&SW" or footage from lines SE SE SE
Lease Owner EMPIRE DRILLING COMPANY AND SIMON LEBOW
Lease Name RUSH Well No. 1
Office Address 400 BROWN BUILDING, WICHITA 2, KANSAS
Character of Well (completed as Oil, Gas or Dry Hole) DRY HOLE
Date well completed MAY 18, 1956 19
Application for plugging filed MAY 18, 1956 19
Application for plugging approved 19
Plugging commenced MAY 18, 1956 19
Plugging completed MAY 18, 1956 19
Reason for abandonment of well or producing formation DRY HOLE

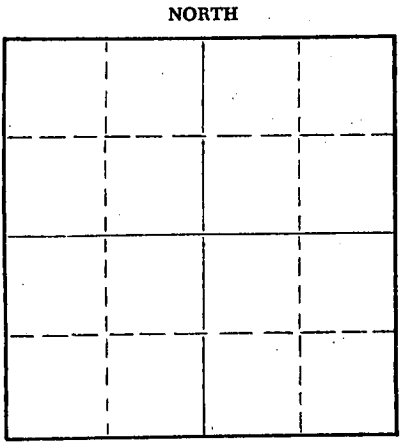

Locate well correctly on above
Section Plat

If a producing well is abandoned, date of last production _____ 19
Was permission obtained from the Conservation Division or its agents before plugging was com-
menced? YES

Name of Conservation Agent who supervised plugging of this well ELDON PETTY
Producing formation _____ Depth to top _____ Bottom _____ Total Depth of Well 4090 Feet
Show depth and thickness of all water, oil and gas formations.

OIL, GAS OR WATER RECORDS

CASING RECORD

FORMATION	CONTENT	FROM	TO	SIZE	PUT IN	PULLED OUT
				8 5/8	178'	CEMENTED

Describe in detail the manner in which the well was plugged, indicating where the mud fluid was placed and the method or methods used in introducing it into the hole. If cement or other plugs were used, state the character of same and depth placed, from _____ feet to _____ feet for each plug set.

BOTTOM PLUG SET AT 175' WITH 1/2 SACK HULLS AND 15 SACKS CEMENT.
TOP PLUG SET AT 40' WITH 1/2 SACK HULLS AND 10 SACKS CEMENT.

(If additional description is necessary, use BACK of this sheet)

Name of Plugging Contractor EMPIRE DRILLING COMPANY
Address 400 BROWN BUILDING, WICHITA 2, KANSAS

STATE OF KANSAS, COUNTY OF SEDGWICK, ss.
I, DAN J. KORNFELD (employee of owner) or (owner or operator) of the above-described well, being first duly sworn on oath, says: That I have knowledge of the facts, statements and matters herein contained and the log of the above-described well as filed and that the same are true and correct. So help me God.

(Signature) [Signature]
DAN J. KORNFELD, 400 BROWN BLDG., WICHITA 2, KANSAS
(Address)

SUBSCRIBED AND SWORN TO before me this 23rd day of MAY, 1956

My commission expires Oct. 21, 1958

[Signature]
STATE CORPORATION COMMISSION
Notary Public.

PLUGGING
FILE SEC. 8 T. 10 R. 25W
BOOK PAGE 65 LINE 5

MAY 23 1956
05-29-56
CONSERVATION DIVISION
WICHITA, KANSAS

LOG

COMPANY: SIMON LEBOW ANDEMIRE DRILLING COMPANY

CONTRACTOR: EMPIRE DRILLING COMPANY

FARM: RUSH # 1

LOCATION: SE SE SE OF SEC. 8-10-25W, GRAHAM COUNTY, KANSAS

COMMENCED: MAY 10, 1956

COMPLETED: MAY 18, 1956

ELEVATION: KB 2547'

0	TO	195	SHALE AND SAND	TOPS:		
195	TO	1370	SHALE AND SHELLS			
1370	TO	1900	SAND AND SHALE	HEEBNER	3791'	-1244
1900	TO	2174	SHALE AND SHELLS	TORONTO	3814'	-1267
2174	TO	2210	ANHYDRITE	LANSING-KANSAS CITY	3834'	-1287
2210	TO	2830	SHALE AND SHELLS	BASE KANSAS CITY	4063'	-1516
2830	TO	2950	SHALE AND LIME			
2950	TO	3040	LIME AND SHALE			
3040	TO	3190	SHALE AND LIME			
3190	TO	3485	LIME AND SHALE			
3485	TO	3775	SHALE AND LIME			
3775	TO	3870	LIME			
3870	TO	3949	LIME AND SHALE			
3949	TO	4035	LIME			
4035	TO	4090	LIME AND SHALE			
4090			R.T.D.			

DRY AND ABANDONED

CASING RECORD: RAN 178' OF 8 5/8" AND CEMENTED WITH 115 SACKS CEMENT.
RAN SCHLUMBER ELECTRIC LOG.

D.S.T. NO. 1 3845-3870 TOOL OPEN 45 MINUTES. FAIR BLOW FOR THREE MINUTES.
RECOVERED 16' OF WATERY MUD. 30 MINUTES BOTTOM HOLE PRESSURE 1300 OLBS.

I, DAN J. KORNFELD, DO HEREBY CERTIFY THAT THE ABOVE AND FOREGOING IS A TRUE AND CORRECT COPY OF THE LOG ON THE RUSH NO. 1, SE SE SE OF SEC. 8-10-25W, GRAHAM COUNTY, KANSAS, AS REFLECTED BY THE FILES OF THE EMPIRE DRILLING COMPANY.

Dan J. Kornfeld
DAN J. KORNFELD

SUBSCRIBED AND SWORN TO BEFORE ME, A NOTARY PUBLIC WITHIN AND FOR SEDGWICK COUNTY, KANSAS, THIS 23rd DAY OF MAY, 1956.

Lucille Han
NOTARY PUBLIC

MY COMMISSION EXPIRES My Commission Expires Oct. 21, 1958

REC
STATE

PLUGGING
FILE SEC. 8 T. 10 R. 25E W
BOOK PAGE 65 LINE 5

CONSERVED