


15-065-20630-0000  
WELL PLUGGING RECORD

See All Information Completely  
Made Required Affidavit  
Mail or Deliver Report to:  
Conservation Division  
State Corporation Commission  
P. O. Box 17027  
Wichita, Kansas 67217  
NORTH

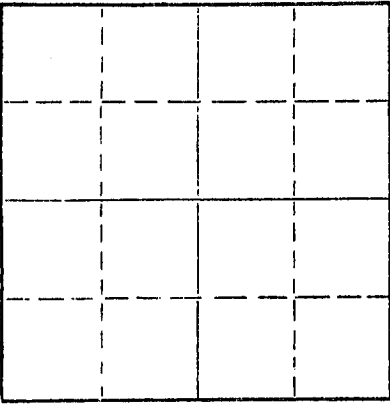

Locate well correctly on above  
Section Plat

Graham County, Sec. 8 Twp. 10S Rge. 25W (E) (W)  
Location as "NE/CNWxSWx" or footage from lines SW NW SW  
Lease Owner Okmar Oil Company  
Lease Name McGuire "C" Well No. 1  
Office Address 1130 Vickers-KSB&T Building, Wichita, Kansas 67202  
Character of Well (completed as Oil, Gas or Dry Hole) D & A  
Date well completed October 24 19 73  
Application for plugging filed October 24 19 73  
Application for plugging approved October 24 19 73  
Plugging commenced October 24 19 73  
Plugging completed October 24 19 73  
Reason for abandonment of well or producing formation D & A

If a producing well is abandoned, date of last production 19  
Was permission obtained from the Conservation Division or its agents before plugging was commenced? Yes

Name of Conservation Agent who supervised plugging of this well Mr. W.L. Nichols  
Producing formation \_\_\_\_\_ Depth to top \_\_\_\_\_ Bottom \_\_\_\_\_ Total Depth of Well 4010 Feet  
Show depth and thickness of all water, oil and gas formations.

OIL, GAS OR WATER RECORDS

CASING RECORD

FORMATION	CONTENT	FROM	TO	SIZE	PUT IN	PULLED OUT
				8-5/8"	276'	-0-

Describe in detail the manner in which the well was plugged, indicating where the mud fluid was placed and the method or methods used in introducing it into the hole. If cement or other plugs were used, state the character of same and depth placed, from \_\_\_\_\_ feet to \_\_\_\_\_ feet for each plug set.

First Plug @ 1050' w/70 sx 50-50 pozmix, 6% Gel.  
Second Plug @ 285' w/20 sx  
Third Plug @ 40' w/10 sx

RECEIVED  
STATE CORPORATION COMMISSION  
NOV 15 1973  
CONSERVATION DIVISION  
Wichita, Kansas

(If additional description is necessary, use BACK of this sheet)  
Name of Plugging Contractor Red Tiger Drilling Company  
Address 1720 Wichita Plaza, Wichita, Kansas 67202


STATE OF Kansas, COUNTY OF Sedgwick, ss.  
Linda H. Dickens (employee of owner) or (owner or operator) of the above-described well, being first duly sworn on oath, says: That I have knowledge of the facts, statements, and matters herein contained and the log of the above-described well as filed and that the same are true and correct. So help me God.

(Signature) Linda H. Dickens  
1720 Wichita Plaza, Wichita, Kansas 67202  
(Address)

SUBSCRIBED AND SWORN TO before me this 13th day of November, 19 73

Linda C. Mowrey  
Notary Public.

May 24, 1977

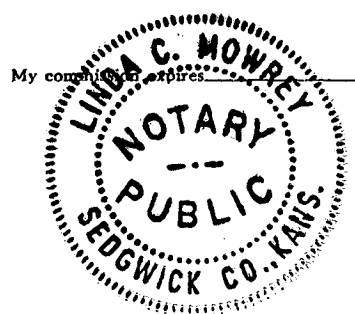

DRILLERS LOG

No. 1 McCrete "C"

CASING RECORD:

8-5/8" @ 276'  
w/185 sx cement

TOTAL DEPTH: 4,010'

COMPANY: Oliver Oil Company

CONTRACTOR: Red Tiger Drilling Co.

COMMENCED: October 4, 1973

COMPLETED: October 24, 1973

DESCRIPTION:

SW NW SW  
8-10S-25W  
Graham County,  
Kansas

ELEVATION:

<u>FORMATION</u>	<u>FROM</u>	<u>TO</u>	<u>REMARKS</u>
Shale	0	625	
Shale & Clay	625	1270	
Shale	1270	1725	
Sand	1725	1900	
Shale	1900	2127	
Anhydrite	2127	2177	
Shale	2177	2735	
Shale & Shells	2735	2885	
Shale & Lime	2885	3790	
Lime	3790	3815	
Lime & Shale	3815	3862	
Lime	3862	4010	

RECEIVED  
STATE CORPORATION COMMISSION

NOV 15 1973

CONSERVATION DIVISION  
Wichita, Kansas

Pipe Stuck @ 3556'.  
Washed Over.

I certify that this is a true and correct copy of the above log to the best of my knowledge.

RED TIGER DRILLING COMPANY

Linda H. Dickens  
Linda H. Dickens

Subscribed and sworn to before me this 12th day of November, 1973.

Linda C. Mourey  
Notary Public

My Commission Expires:

May 24, 1977

