

15-195-21146-00-00

STATE OF KANSAS
STATE CORPORATION COMMISSION

WELL PLUGGING RECORD

Give All Information Completely
Make Required Affidavit
Mail or Deliver Report to
Conservation Division
State Corporation Comm.
245 North Water
Wichita, KS 67202

Trego County, Sec. 19 Twp. 12S Rge. 22 ~~NE~~/W
Location as "NE/CNW $\frac{1}{4}$ SW $\frac{1}{4}$ " or footage from lines
NW NE NE


Lease Owner Hummon Corporation
Lease Name STAAB Well No. 1
Office Address One Main Pl. Suite 400, Wichita, KS 67202
Character of Well (Completed as Oil, Gas or Dry Hole) DRY HOLE

Date Well completed 1-1-1983
Application for plugging filed 1-1-1983
Application for plugging approved 1-1-1983
Plugging commenced 1-1-1983
Plugging completed 1-1-1983
Reason for abandonment of well or producing formation D & A

If a producing well is abandoned, date of last production 19

Was permission obtained from the Conservation Division or its agents before plugging was commenced? YES

Name of Conservation Agent who supervised plugging of this well Dennis Hamel
Producing formation _____ Depth to top _____ Bottom _____ Total Depth of Well 4080'
Show depth and thickness of all water, oil and gas formations.

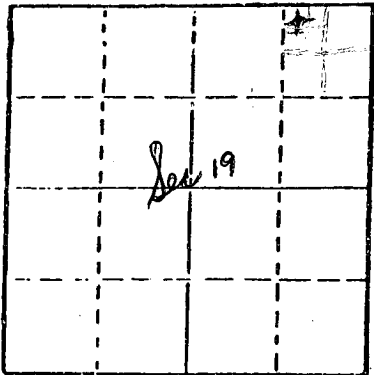

Locate well correctly on above Section Plat

OIL, GAS OR WATER RECORDS

CASING RECORD

FORMATION	CONTENT	FROM	TO	SIZE	PUT IN	PULLED OUT
		0	226'	8 5/8	224'	0

Describe in detail the manner in which the well was plugged, indicating where the mud fluid was placed and the method or methods used in introducing it into the hold. If cement or other plugs were used, state the character of same and depth placed, from _____ feet to _____ feet for each plug set.

4080' T.D. 180 Sacks 50-50 Posmix 6% Gel
Bottom Plug at 1885' with 20 Sacks
2nd Plug at 1000' with 100 Sacks
3rd Plug at 230' with 40 Sacks
Top Plug Solid Bridge at 40' with 10 Sacks
Rathole 10 Sacks
Plug down @ 5:30 P.M. 1-1-83
Sun Cementing

(If additional description is necessary, use BACK of this sheet)

Name of Plugging Contractor Blue Goose Drilling Company, Inc.

STATE OF KANSAS COUNTY OF BARTON, ss.
George E. Miller, Jr. (~~employee of owner~~) or (owner or operator)
of the above-described well, being first duly sworn on oath, says: That I have knowledge of the facts, statements, and matters herein contained and the log of the above-described well as filed and that the same are true and correct. So help me God.

(Signature) George E. Miller, Jr.
P.O. Box 1413 Great Bend, KS 67530
(Address)

SUBSCRIBED AND SWORN TO before me this 4th day of January, 19 83.

Helen C. Standley
Helen C. Standley, Public.

My commission expires 12-8-83

STATE CORPORATION COMMISSION

STATE NOTARY PUBLIC
HELEN C. STANDLEY
Barton County, Kansas
My Appt. Exp. 12-8-83

JAN 06 1983
01-06-1983
CONSERVATION DIVISION
Wichita, Kansas

15-195-21146-00-00

WELL LOG

1 STAAB
NW NE NE Sec 19-12S-22W
TREGO COUNTY, KS

NAME OF OPERATOR: Hummon Corporation
One Main Place Suite 400
Wichita, KS 67202

DATE COMPLETED: January 1, 1983

FROM	TO	
0	226	Clay, Sand & Shale
226	1630	Shale
1630	1995	Sand and Shale
1995	4080	Shale & Lime
4080		T.D.
Anhydrite 1837 to 1885		

STATE OF KANSAS


COUNTY OF BARTON ss

George E. Miller, Jr., President of Blue Goose Drilling Company, Inc. being first duly sworn on oath says: That I have knowledge of the facts, statements and matters herein contained and the log of the above described well as filed and that the same are true and correct.

George E. Miller, Jr.

George E. Miller, Jr.

Subscribed and sworn before me this 4th Day of January 1983.

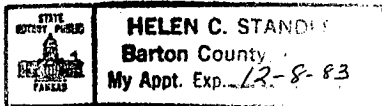

Helen C. Standley

Helen C. Standley, Notary Public

My Commission Expires: 12-8-83

RECEIVED
STATE CORPORATION COMMISSION

JAN 06 1983
DL-06-983
CONSERVATION DIVISION
Wichita, Kansas