

15-035-19413-00-00

R

STATE OF KANSAS
STATE CORPORATION COMMISSION

Form CP-4

Give All Information Completely
Make Required Affidavit
Mail or Deliver Report to:
Conservation Division
State Corporation Commission
211 No. Broadway
Wichita, Kansas

WELL PLUGGING RECORD

Cowley County, Sec. 24 Twp. 31 Rge. 4 (E) ~~XX~~

Location as "NE/CNWSW" or footage from lines SW SE NW

Lease Owner Buckeye Supply Company of Kansas, Inc.

Lease Name Gibson Well No. 1

Office Address Box 1020, El Dorado, Kansas

Character of Well (completed as Oil, Gas or Dry Hole) oil well

Date well completed 10-16-55 19

Application for plugging filed 11-5-65 19

Application for plugging approved 11-8-65 19


Plugging commenced 12-1-65 19

Plugging completed 12-3-65 19

Reason for abandonment of well or producing formation depleted

If a producing well is abandoned, date of last production 19

Was permission obtained from the Conservation Division or its agents before plugging was commenced? yes

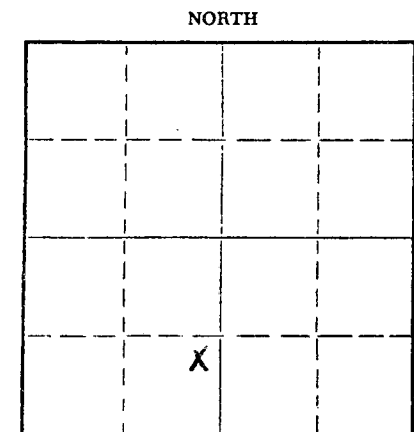

Locate well correctly on above Section Plat

Name of Conservation Agent who supervised plugging of this well Howard Hess

Producing formation Depth to top Bottom Total Depth of Well 2960 Feet

Show depth and thickness of all water, oil and gas formations.

OIL, GAS OR WATER RECORDS

CASING RECORD

FORMATION	CONTENT	FROM	TO	SIZE	PUT IN	PULLED OUT
				8 5/8	90	none
				5 1/2	2846	1347

Describe in detail the manner in which the well was plugged, indicating where the mud fluid was placed and the method or methods used in introducing it into the hole. If cement or other plugs were used, state the character of same and depth placed, from feet to feet for each plug set.

Fill hole with gravel from 2960' to 2840' and dump 5 sacks cement.
Set 15' rock bridge from 225' to 210' and dump 25 sacks cement.
Mud hole to 25', rock bridge to 20' and dump 5 sacks cement.

RECEIVED
STATE CORPORATION COMMISSION

DEC 10 1965

CONSERVATION DIVISION
Wichita, Kansas

(If additional description is necessary, use BACK of this sheet)

Name of Plugging Contractor Flint Engineering & Construction Company

Address Box 950, El Dorado, Kansas

STATE OF KANSAS, COUNTY OF BUTLER, ss.

(employee of owner) or (owner or operator) of the above-described well, being first duly sworn on oath, says: That I have knowledge of the facts, statements, and matters herein contained and the log of the above-described well as filed and that the same are true and correct. So help me God.

(Signature) *Gaura Bawdle*

El Dorado, Kansas (Address)

7th day of December, 1965

Ronald P. Hanson

Notary Public.



9-27-67

commission expires

Buckeye Supply
Cemented at 2845
N/150 Sacks

24-31-4E

DRILLING LOG

15-035-19413-00-00

SR

Company: H. H. Blair
600 Bitting Bldg.,
Wichita, Kansas

Elevation: Est. 1207 D.F.
1205 Ground

Lease : Gibson

Well: #1

Location: SW SE NE of Section 24, Township 31, Range 4 East, Cowley
County, Kansas

Contractor: Bedell-Catt Drilling Co., Inc.
605 Union National Bank Bldg.,
Wichita 2, Kansas

Date Comm: October 8, 1955

Date Compl: October 16, 1955

T.D. 2960'

Casing: 8 5/8" to 90'
5 1/2" to 2846'

RECORDED
INDEXED
OCT 10 1955

DEC 10 1965

Figures Indicate the Bottom of Formation

0-90	Surface	2515	Lime & shale
645	Lime & shale	2595	Shale
980	Shale & shells	2620	Lime & shale
1035	Shale & shells	2645	Shale
1510	Lime & shale	2840	Shale & lime
1545	Lime	2840-2862'	Coring
1755	Lime & shale	2947	Shale & shells
1910	Shale & sand	2960	Lime
1955	Sandy lime		
2035	Lime & shale	2960'	T.D.
2055	Shale		
2305	Shale & shells		
2370	Shale & lime		
2455	Lime		

I certify the above to be true and correct to the best of my
knowledge and belief.

BEDDELL-CATT DRILLING CO., INC.

By George W. Catt
George W. Catt

Subscribed and sworn before me this 25th day of October, 1955.

Charles E. Helber
Notary Public

My Commission Expires:

March 18, 1958